

**KANSAS**

Pratt


Section 33 Township 26 Range 13W

Well No. 3 Strait

Company Deep Rock & Lion

**Chance**

NORTH

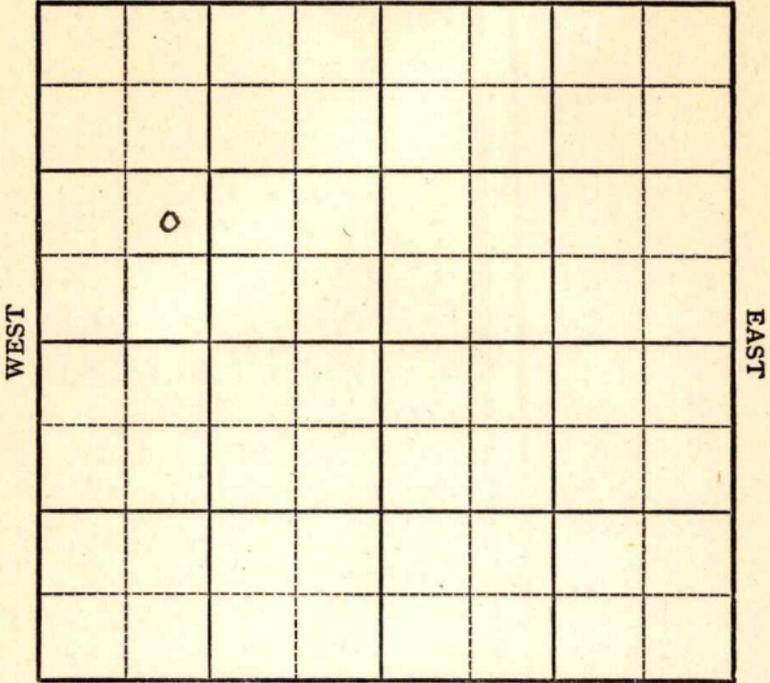

SOUTH

**KANSAS**

Sec. 33 Twp. 26 R. 13W

Well No. #3 Strait Farm \_\_\_\_\_

Deep Rock & Lion Company \_\_\_\_\_

Chance Pool

\_\_\_\_\_ Ft. from N. Line


990'

\_\_\_\_\_ Ft. from S. Line

\_\_\_\_\_ Ft. from E. Line

990'

\_\_\_\_\_ Ft. from W. Line

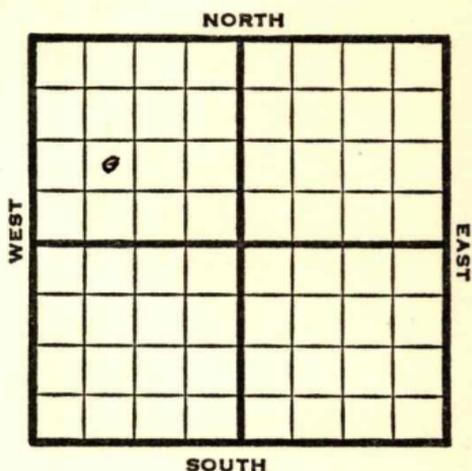

NE SW NW

1949

**Elev 1962'**

REPORT

5/25

RUR

6/1

"

6/7

8" @ 808'

Drlg 2580'

6/15

**Simpson Shale 4346'**

Drlg. 4347'

6/21

**Lansing 3783'**

**Simpson Sd 4347'**

**Arbuckle 4430'**

TD 4432'

5" @ 4430'

6/29

TD 4437'

**Arb. 4430'**

5" @ 4430'

150 acid

Pump 75 Oil  $\neq$  10 W Pot

42° Gr.

Comp

**COMPLETED**

Map No. \_\_\_\_\_ Sec. 33 Twp. 26 R. 13W

Well No. 3 Strait

Deep Rock & Lion Company

Contractor

~~NE~~ SW NW

FIRST REPORT  
SECTION PLAT

\_\_\_\_\_ Ft. from N. Line

990 Ft. from S. Line

\_\_\_\_\_ Ft. from E. Line

990 Ft. from W. Line

	a		

Pratt County

Location \_\_\_\_\_

Rig up \_\_\_\_\_

Drilling and Remarks:

R U R

RECORD

Cased \_\_\_\_\_ in., \_\_\_\_\_ ft.

Sand \_\_\_\_\_

Gas \_\_\_\_\_

Oil \_\_\_\_\_

Total Depth \_\_\_\_\_

PRODUCTION

1st 24 hrs. Nat. \_\_\_\_\_

1st 24 hrs. after shot \_\_\_\_\_

Gas \_\_\_\_\_ Cu. Ft.

Dry Hole \_\_\_\_\_

Abandoned \_\_\_\_\_

Date

MAY 25 1949 19

S. J. LEWIS

Scout

