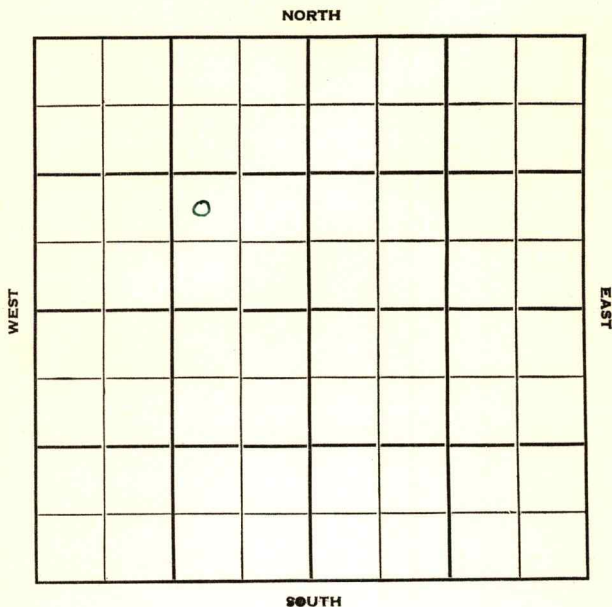


Section 33 Township 26 Range 13WWell No. #5 StraitCompany Deep Rock

Pratt

KANSAS 13W

Sec. 33 Twp. 26 R. 13W

Well No. #5 Strait Farm

Deep Rock Company

Chance Contractor


Ft. from N. Line

990' Ft. from S. Line

990' Ft. from E. Line

Ft. from W. Line

NW SE NW

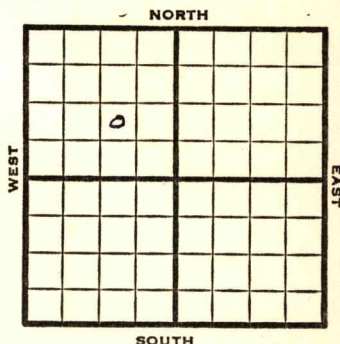

1951

Elev. 1960'

REPORT

11/14

Spud 11-8-51
8" @ 870
Drlg. 3020

1952
1/2

Spud 11-8-51
Oil well TD 4464' 8" @ 870'
DST 3955-70 open 1/2 hr. rec 30' mud
DST 4197-4232' open 45 min. rec 30' mud
DST 4238-65 open 4 5 min, rec 120'
GCM
DST 4286-4314 open 45 min, flowed oil
DST 4337-65 open 1 hr. rec 630' oily
mud, 360' OCW, 90' water
DST 4437-55 open 1 hr. rec 315' OCM
225' muddy oil, 180' OCW, 180' water
TD 4464' 5" @ 4464 Heeb 3606'
Br. lime 3772' Lans. 3796'
Miss 4191' Kh. 4224' Viola 4239'
Simp. 4337' Arb. 4424'
24/4294-4302 18/4310-16
F/25 BOPH F/110 BO 7 hr.
F/293 BOPD

COMPLETED

County **Pratt** State **Kansas**Sec. **33** (Blk.) **26** (Sur.) **13W** Map No.Operator **Deep Rock**Well No. **5** Farm **Strait**Elev. **1960** Location **NW SE NW**

FIRST REPORT

990 Ft. From **S** Line **NW****990**
830 Ft. From **E** Line Quarter1st. Report **NOV 14 1951**

Completion

Remarks

Spudding Date **11-8-51**Drlg. Data **Chance****8" @ 870 Drlg. 3020****J. E. TYRA**



Operator Deep Rock

Well No. 5 Farm Strait

Elev.	1960	Location	NW SE NW
-------	------	----------	----------


990 Ft. From S Line NW

990 Ft. From E Line Quarter

1st. Report

Completion JAN 2 1952

Remarks	Chance Pool
---------	-------------

Spudding Date 11-8-51

Drilg. Data Oil well TD 4464

8" @ 870 DST 3955-70 open $\frac{1}{2}$ hr.

Rec. 30' mud DST 4197-4232 open 45 min.

Rec. 30' mud DST 4238-65 open 45 min.

Rec. 120' gom DST 4286-4314 open 45 min
flowed oil DST 4337-65 open 1 hr.

Rec. 630' oily mud 360' ocw 90' water

DST 4437-55 open 1 hr. Rec. 315' ocm

225' muddy oil 180' ocw 180' water

TD 4464 5" @ 4464 Heeb. 3606

Br. lime 3772 Lans. 3796 Miss. 4191

Kh. 4224 Viola 4239 Simp. 4337

Arb. 4424 24. 4294-4302 18/ 4310-16

F/ 25 boph F/ 110 bo 7 hr.

F/ 293 bopd

J. E. TYRA