

KANSAS

Section 33 Township 26 Range 13W

Well No. #11 Calbeck

Company Deep Rock

NORTH

					0		

WEST

EAST

SOUTH

Pratt

KANSAS

Sec. 33 Twp. 26 R. 13W

Well No. #14 Calbeck Farm

Deep Rock Company

Contractor


Ft. from N. Line

330' Ft. from S. Line

Ft. from E. Line

990' Ft. from W. Line

SE SW NE

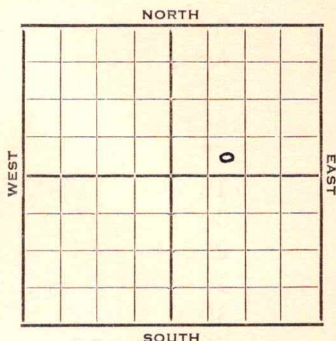

1952

Elev. 1961'

REPORT

1/30 Spud 1-24-52
8" @ 838
Drlg. 2815'

2/6 Drlg. 4297'

2/13 Heeb. 3611 Lans. 3802
Miss 4196 KH 4235
Viola 4246 Simp. 4327
DST 4326-52, 35 mins. 30' m
Arb. 4429
DST 4452-67 1 hr. 10' HOCM 10'
muddy oil 30' free oil TD 4467
5" @ 4466

2/20 24/4293-4301 N.S. 30/4309-19 15 gal
oil ph 500 A 20 gal & 3 BWPH for
15 hrs. sq. off.

3/5 Sq perfs Co to 4320 56/4309-17
B/1½ gal oil & 1½ gal wtr 1 hr.
Hyd S/56 BO 12 hr.

3/12 NR

3/19 "

3/26 Spud 1-24-52 Oil well TD 4467'
8" @ 838'
DST 3816-40 open 45 min, rec 45' SO &
GCM
DST 3947-76 open 45 min, rec 30' SGCM

OVER

1952
3/26

(Information continued)

DST 4186-4205 open 45 min, rec 1620'
gas, 40' GCM

DST 4205-32 open $\frac{1}{2}$ hr, rec 30' rotary
mud.

Heeb 3611' Lans. 3802' Miss 4196'

Kh. 4235' Viola 4246' Simp. 4327'

DST 4326-52 open 35 min. rec 30' mud

Arb. 4429'

DST 4452-67 open 1 hr. rec 60' HOCM,
60' muddy oil, 30' free oil, TD 4467'
5" @ 4466' 24/4293-4301' 30/4309-19

15 GOPH 500 A 20 GO 3 BWPH

CO to 4316' 54/4306-15 test mud

200 A 15 GO Hydro. S/2 $\frac{1}{2}$ BFPH

30 GOPH 8 hr. DP 4415 23/4315-19

3000 A SSO & water 31 hr. CO to 4320

56/4309-17 B/1 $\frac{1}{2}$ GO 1 $\frac{1}{2}$ GWPH Hydro

S/56 BO 12 hr.

Comp. 140 BOPD

COMPLETED

County Pratt State Kansas
 Sec. 33 (Blk.) 26 (Sur.) 13W Map No.

Operator Deep Rock

Well No. 14 Farm Calbeck

Elev. Location SE SW NE



330 Ft. From S Line NE

990 Ft. From W Line Quarter

1st. Report JAN 30 1952

Completion

Remarks

Spudding Date 1-24-52

Drlg. Data Chance

8" @ 838 Drlg. 2815


J. G. McGEHEE

County Pratt State Kansas
 Sec. 33 (Blk. 26) (Sur. 13W) Map No.

Operator Deep Rock

Well No. 14 Farm Calbeck

Elev. 1961 Location SE SW NE

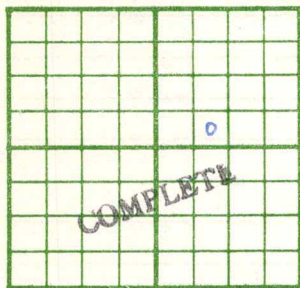

330 Ft. From S Line NE

990 Ft. From W Line Quarter

1st. Report

Completion MAR 26 1952

Remarks Chance Pool

Spudding Date 1-24-52

Drilg. Data Oil well TD 4467

8" @ 838 DST 3816-40 open 45 min.

Rec. 45' so & gcm DST 3947-76

open 45 min. Rec. 30' sgcm DST 4186-

4205 open 45 min. Rec. 1620' gas

40' gcm DST 4205-32 open $\frac{1}{2}$ hr.

Rec. 30' rotary mud Heeb. 3611

Lans. 3802 Miss. 4196 Kh. 4235

Viola 4246 Simp. 4327 DST 4326-52

open 35 min. Rec. 30' mud Arb. 4429

DST 4452-67 open 1 hr. Rec. 60' hocom

60' muddy oil 30' free oil TD 4467

5" @ 4466 24/ 4293-4301 30/ 4309-19

15 goph 500 A 20 go 3 bwph

J. G. McGEHEE

Drlg. Data

CO to 4316 54/ 4306-15 test mud
200 A 15 go Hydro. S/ $2\frac{1}{2}$ bfph
30 goph 8 hr. DP 4415 23/ 4315-19
3000 A SSO & water 31 hr. CO to 4320
56/ 4309-17 B/ $1\frac{1}{2}$ go $1\frac{1}{2}$ gwph Hydro.
S/ 56 bo 12 hr. Comp. 140' bopd

1961

APR 2

see see