

Section 33 Township 26 Range 13W

Well No. #3 Joe

Company Rine Dlr.

NORTH

	9						

WEST

EAST

SOUTH

Pratt

Sec. 33 Twp. 26 R. 13W

Well No. #3 Joe Farm ✓

Rine Drlg.

Company

Contractor


330' Ft. from N. Line

Ft. from S. Line

Ft. from E. Line

990' Ft. from W. Line

NE NW SW

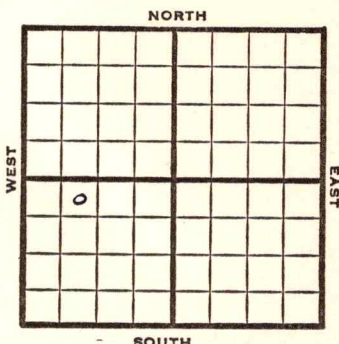

1952 **Elev. 1961'** REPORT

- 2/27 Spud 2-13-52
8" @ 848
Miss 4187
DST 4187-4205 10 mins
5 M gas 60' oil 1290#
DST 4205-35 45 mins. 60' GCM
V 4243
DST 4243-65 45 mins. 90' GCM
DST 4281-4330 20 mins flowed oil 20 min.
DST 4440-63 1 hr. TD 4463
5" @ ? WOCT
- 3/5 TD 4503- Cor.
DST 4440-63 Rec. 2130' oil, gas & wtr
5" @ 4480
Heeb. 3616 Br Li 3774
Lans. 3799 Miss 4190
V 4244 Simp 4342
Arb. 4440
- 3/12 95/4294-4303 F 42 BO 2 hrs.
- 3/19 Spud 2-13-52
Oil well TD 4503' 8" @ 848'
Miss 4190'
DST 4187-4205 open 10 min, rec 5 M gas 60' oil.
DST 4205-35, open 45 min, rec 60' GCM

OVER

1952
3/19

(Information continued)

Viola 4244'

DST 4243-65 open 45 min, rec 90' GCM

DST 4281-4330 open 20 min.

F/oil 20 min.

DST 4440-63, open 1 hr.

TD 4463' 5" @ 4480 DD 4503'

Heeb 3616' Br. lime 3774' Lans 3799

Simp 4342' Arb. 4440'

95/4294-4303 F/42 BO 2 hr.

Comp. 331 BOPD

COMPLETED

County **Pratt** State **Kansas**
 Sec. **33** (Blk.) **26** (Sur.) **13W** Map No.
 Operator **Rine Drlg.**
 Well No. **3** Farm **Joe**
 Elev. **1961** Location **NE NW SW**

FIRST REPORT

330 Ft. From **N** Line **SW**
990 Ft. From **W** Line **Quarter**
 1st. Report **FEB 27 1952**
 Completion
 Remarks

Spudding Date **2-13-52**

Drlg. Data **Chance**

8" @ 848 Miss 4187 DST 4187-4205 10 mins
5 1/2" gas 60' oil 1290# DST 4205-35 45 mins.
60' gem.V 4243 DST 4243-65 45 mins. 90'
gem. DST 4281-4330 20 mins flowed oil
20 min. DST 4440-63 1 hr. TD 4463
5" @ ? W.O.C.T.

J. G. McGEHEE

J. G. McGEHEE