


Section 33 Township 26 Range 13 W

Well No. # 6 Strait

Company Deep Rock Oil

NORTH

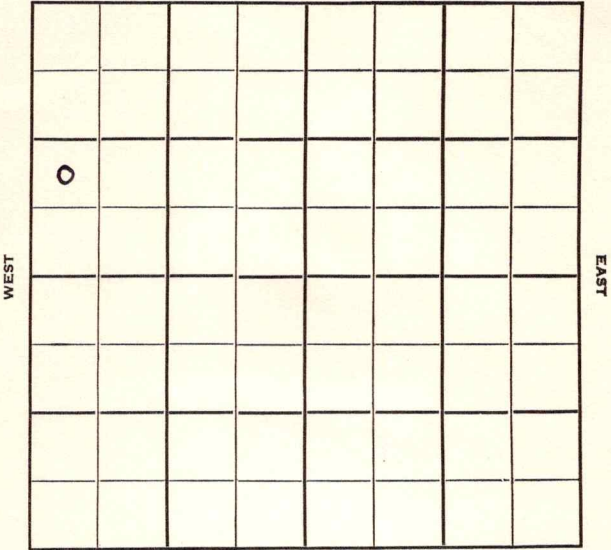

WEST

EAST

SOUTH

Sec. 33 Twp. 26 R. 13 W

Well No. # 6 Strait Farm \_\_\_\_\_

Deep Rock Oil Company \_\_\_\_\_

Rine Drlg. Contractor \_\_\_\_\_

Chance Pool


Ft. from N. Line

990 Ft. from S. Line

Ft. from E. Line

330 Ft. from W. Line

NW SW NW

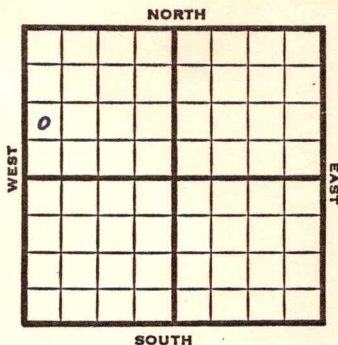

1951 **Elev. 1962'** REPORT

12/12 Cellar & Pits

1952

1/30

Spud 12-12-51  
 Oil Well TD 4465  
 8" @ 860 DST 3808-27 opn 1hr.  
 Rec. 25' socm DST 3923-55 opn 1 hr.  
 Rec. 25' gcm DST 4191-4225 opn  
 45 min. Rec. 250' gcm  
 DST 4311-30 opn 45 min.  
 Rec. 2380' oil DST 4439-50 opn 1/2 hr.  
 Rec. 15' mud DST 4450-65 opn 1 hr.  
 Rec. 30' mud 150' gas 5" @ 4464  
**Heeb. 3604 Br lime 3767**  
**Lans. 3794 Miss 4194**  
**Kh 4230 Viola 4246**  
**Simp 4343 Arb. 4424**  
 75/4309-34 S/97 bo 12 hr. 500 A  
 S/183 bo 17 hr. Comp. 174 bopd

**COMPLETED**

County **Pratt** State **KANSAS**

Sec. **33** (Blk. Twp.) **26** (Sur. Rge.) **13W** Map No.

Operator **Deep Rock Oil**

Well No. **6** Farm **Strait**

Elev. Location **NW SW NW**


**990** Ft. From **S<sup>1</sup>/<sub>2</sub>** Line **NW**

**330** Ft. From **W** Line **Quarter**

1st. Report **DEC 1 2 1951**

Completion

Remarks

**Rine Drlg. - Contr.**

Spudding ~~Date~~

Drlg. Data **Chance Pool**

**Cellar & pits**

**J. E. TYRA**

County Pratt State Kansas

Sec. 33 (Blk. 26) (Sur. Rge.) 13W Map No.

Operator Deep Rock Oil

Well No. 6 Farm Strait

Elev. 1962 Location NW SW NW

0				

**COMPLETE**

990 Ft. From S Line NW  
 330 Ft. From W Line Quarter

1st. Report

Completion JAN 30 1952

Remarks Chance Pool

Rine Drlg. - Contr.

Spudding Date 12-12-51

Drlg. Data Oil well TD 4465

8" @ 860 DST 3808-27 open 1 hr.

Rec. 25' socm DST 3923-55 open 1 hr.

Rec. 25' gcm DST 4191-4225 open 45 min.

Rec. 250' gcm DST 4311-30 open 45 min.

Rec. 2380' oil DST 4439-50 open 1/2 hr.

Rec. 15' mud DST 4450-65 open 1 hr.

Rec. 30' mud 150' gas 5" @ 4464

Heeb. 3604 Br. lime 3767 Lans. 3794

Miss. 4194 Kh. 4230 Viola 4246

Simp. 4343 Arb. 4424 75/ 4309-34

S/ 97 bo 12 hr. 500 A S/ 183 bo

17 hr. Comp. 174 bopd

J. G. McGEHEE