

Section 33 Township 26 Range 13 W

Well No. # 3 Taylor

Company Sunray Oil

NORTH

WEST

EAST

SOUTH

Pratt

KANSAS

Sec. 33 Twp. 26 R. 13W

Well No. #3 Taylor Farm

Sunray Oil Company

Irion Drlg.-Contr. Contractor

Chance Pool


330' Ft. from N. Line

Ft. from S. Line

Ft. from E. Line

330' Ft. from W. Line

NW NW NW

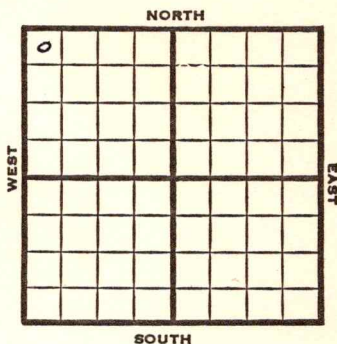

1951

Elev. 1955'

REPORT

5/23

RUR

7/11

Spud 5-28-51 Oil well TD 4448'
8" @ 864' **Br. lime 3775' Lans 3798'**
DST 3847-71 open 1 hr. rec 90' oil
& GCM 60' water
Miss 4252' Simp. 4437-48'
5" @ 4393' TD 4448' 24/4266-72
24/4262-68 FU 200' oil 1 hr.
S/23 BO 9 hr. Hydrofrac
F/256 BO 8 hr. F/101 BOPD
Comp. F/74 BOPD

COMPLETED

County Pratt State KansasSec. 33 (Blk.) 26 (Sur.) 13W Map No.Operator Sunray OilWell No. 3 Farm TaylorElev. Location NW NW NW

0									

FIRST REPORT

330 Ft. From N Line NW330 Ft. From W Line Quarter1st. Report MAY 23 1951

Completion

Remarks

Iron Drlg. - Contr.

Spudding Date

Chance Pool

Drlg. Data

RUR

J. E. TYRA

County Pratt State Kansas
 Sec. 33 (Blk. 26 (Sur. 13W Map No.
 (Twp.) (Rge.)
 Operator Sunray Oil
 Well No. 3 Farm Taylor
 Elev. 1955 Location NW NW NW

0							

COMPLETE

330 Ft. From N Line NW
330 Ft. From W Line Quarter
 Ist. Report
 Completion JUL 11 1951
 Remarks Chance Pool
Iron Drlg. - Contr.
 Spudding Date 5-28-51

Drlg. Data Oil well TD 4448
8" @ 864 Br. lime 3775 Lans. 3798
DST 3847-71 open 1 hr. Rec. 90' oil
& gcm 60' water Miss. 4252
Simp. 4437-48 5" @ 4393 TD 4448
24/ 4266-72 24/ 4262-68 FU 200' oil
1 hr. S/ 23 bo 9 hr. Hydrofrac
F/ 256 bo 8 hr. F/ 101 bopd
Comp. F/ 74 bopd

J. E. TYRA