


KANSAS Pratt

FORM 51 5M 6-46 PETROL

Section 33 Township 26 Range 13-W

Well No. #1 Jo Lemon

Company Lion Chemical

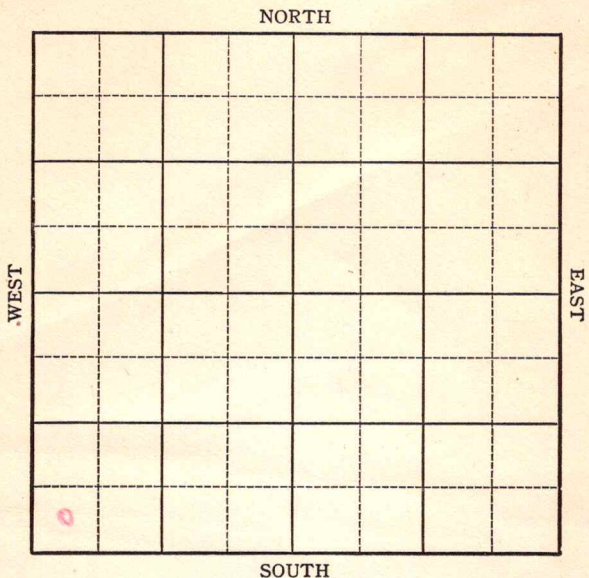

KANSAS

Pratt County

Sec. 33 Twp. 26 R. 13W

Well No. #1 Jo Lemon Farm

Lion Chemical Company

No name


 Ft. from N. Line

330 Ft. from S. Line

 Ft. from E. Line

330 Ft. from W. Line

SW/c

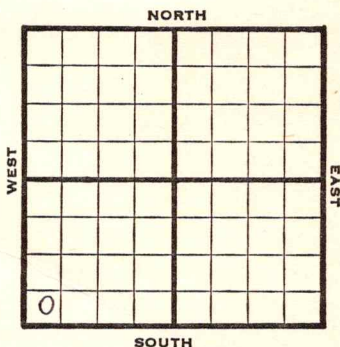

1946

1963

REPORT

8/14 Location
8/20 Derrick
8/27 8" @ 325
Drlg 2900'
9/5 Lans 3790
Viola 4260
Simp sd 4341
Drlg 4405'
9/10 Arb 4433
TD 4443
5" @ 4436 1000 acid
9/18 " " "
9/24 Pump 45 oil plus 1% W in 24 hrs
10/1 " " "
10/9 Arb 4433'
5" @ 4436'
2000 Acid
Pump 51 POT
TD 4443'
Grav. 39

COMPLETED

KANSAS

Kansas Pool Name No nameMap No. 83 Sec. 33 Twp. 26 R. 13WWell No. 1 Jo LemonLion Chemical


Company

FIRST REPORT

Contractor

SW/C

SECTION PLAT

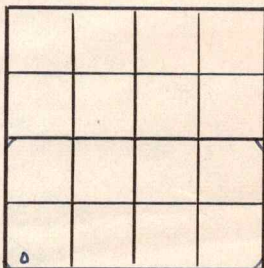 Ft. from N. Line330 Ft. from S. Line Ft. from E. Line330 Ft. from W. LinePratt CountyLocation xRig up

Drilling and Remarks:

RECORD

Cased in., ft.Sand Gas Oil Total Depth

PRODUCTION

1st 24 hrs. Nat. 1st 24 hrs. after shot Gas Cu. Ft.Dry Hole Abandoned

Date

AUG 14 1946 19S. J. LEWIS

Sec

Map No. 83 Sec. 33 Twp. 26 R. 13W

Well No. 1 Jo Lemon

Lion Chemical Company

COMPLETED

Contractor

SW/C

E. 1/1963

SECTION PLAT

 Ft. from N. Line

330 Ft. from S. Line

 Ft. from E. Line

330 Ft. from W. Line

Pratt County

Location

Rig up

Drilling and Remarks:

Art 4423
5' 10" 4426
2000 acd
Pump 51 ft.
39° 44

RECORD

Cased in., ft.

Sand

Gas

Oil

Total Depth 4443

PRODUCTION

1st 24 hrs. Nat.

1st 24 hrs. after shot

Gas Cu. Ft.

Dry Hole

Abandoned

Date

OCT 9 1946 19 S. J. LEWIS Scout