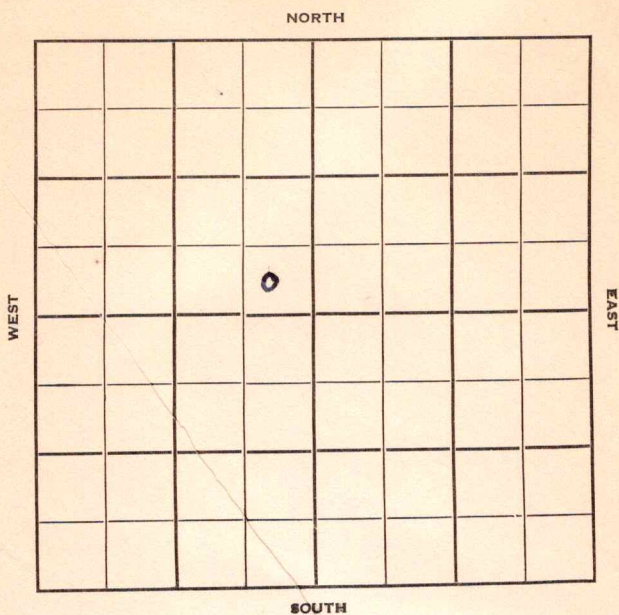


Pratt

KANSAS

Section 33 Township 26 Range 13 WWell No. # 8 StraitCompany Deep Rock

Pratt

KANSAS



Sec. 33 Twp. 26 R. 13W

Well No. #8 Strait Farm

Deep Rock Company

Rine- Contr. Contractor


Ft. from N. Line

330' Ft. from S. Line

406' Ft. from E. Line

Ft. from W. Line

SE SE NW

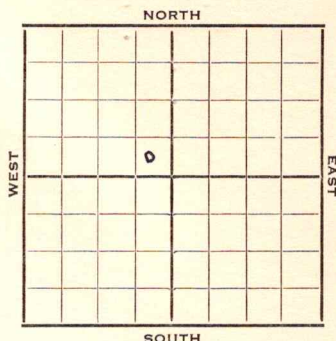

1952 Elev. 1958 REPORT

4/30 Spud 4-26-52
8" @ 865
Drlg. 2105'

5/7 Heeb. 3603 Lans. 3791
DST 3809-3835 1 hr. 120' gas 35' GCM
50# Drlg. 4000'

5/14 RTD 4473' 5" @

5/21 V 4282 Simp. 4334
Arb. 4435
5" @ 4470' 96/ 4283-4308 500 A
S/ 30 BSWPH 800' off btm. fill up
2350 SW 6 hrs. sq. off.

5/28 CO 4436 88/4286-4306 D-Hyd
S/46 BO 12 hrs. S/16 BO 7 hrs.

6/11 POP

6/18 Spud 4-26-52
Oil well TD 4473' 8" @ 865
Heeb 3603' Lans. 3791'
DST 3809-3835 open 1 hr. rec 120' gas
35' GCM
DST 3971-4000 open 1 hr, rec 60' SOCM
Miss 4184'
DST 4184-4200 open ?, rec 15' mud
Kh. 4221'
DST 4235-63 open 1 hr, rec 60' GCM
DST 4281-4330 open 1 hr. rec 150' SOCM

OVER

1952

6/18

(Information continued)

DST 4434-45 open 1 hr. rec 270' O & M
750' free oil, 600' SW TD 4473'

Viola 4282' Simp. 4334' Arb. 4435'

5" @ 4470 96/4283-4308 500 A

S/30 BSWPH FU 2550' SW 6 hr.

Sq. off. CO to 4436' 88/4284-4306

D-Hydro. S/46 BO 12 hr. S/16 BO

7 hr.

Comp. 116 BOPD

COMPLETED

Well No. 8 Farm Strait

Elev.	1958	Location	SE SE NW
-------	------	----------	----------


330 Ft. From S Line NW

406 Ft. From E Line Quarter

1st. Report APR 30 1952

Completion

Remarks

Rine - Contr.


Spudding Date 4-26-52

Drlg. Data

8" @ 865 Drlg. 2105

J. G. McGEHEE

County Pratt State Kansas
 Sec. 33 (Blk. 26 (Sur. 13W Map No.
 (Twp.) (Rge.)
 Operator Deep Rock
 Well No. 8 Farm Strait
 Elev. 1958 Location SE SE NW

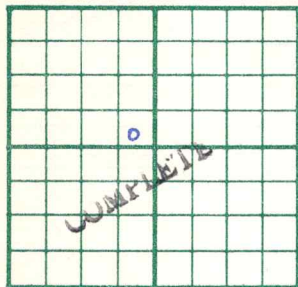

330 Ft. From S Line NW

406 Ft. From E Line Quarter

1st. Report

Completion JUN 1 8 1952

Remarks

Rine Drlg. - Contr.

Spudding Date 4-26-52

Drlg. Data Oil well TD 4473

8" @ 865 Heeb. 3603 Lans. 3791

DST 3809-3835 open 1 hr. Rec. 120' gas

35' gcm DST 3971-4000 open 1 hr.

Rec. 60' socm Miss. 4184 DST 4184-4200

open ? Rec. 15' mud Kh. 4221

DST 4235-63 open 1 hr. Rec. 60' gcm

DST 4281-4330 open 1 hr. Rec. 150' socm

DST 4434-45 open 1 hr. Rec. 270' o & m

750' free oil 600' sw TD 4473

Viola 4282 Simp. 4334 Arb. 4435

5" @ 4470 96/ 4283-4308 500 A

S/ 30 bswph FU 2550' sw 6 hr. sq off.

CO to 4436 88/ 4284-4306 D-Hydro.

J. G. McGEHEE

Drlg. Data

S/ 46 bo 12 hr.

Comp. 116 bopd

JUN 25 1952

Scout Cards
Land Small Map
Land Wall Map
Tracings
Pierce Map
Misc.

[Handwritten signature]