

Section 33 Township 26 Range 13 W

Well No. 2 Taylor

Company Sunray

Chance

NORTH

	0						

WEST

EAST

SOUTH

Pratt

KANSAS ✓

Sec. 33 Twp. 26 R. 13W

Well No. #2 Taylor Farm

Sunray

Company


Chance Pool (Rine Drlg., Cont.)

990' Ft. from N. Line

_____ Ft. from S. Line

_____ Ft. from E. Line

990' Ft. from W. Line

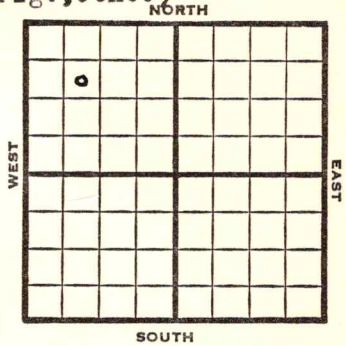

SE NW NW

1949 **Elev. 1960'** REPORT

8/31 8" @ 795'
Drlg. 1630'

9/7 **Lansing 3772'**
Drlg. 4010'

9/14 **Viola 4232'**
Simpson sh 4344 drlg

9/21 **Arbuckle 4413'**
TD 4415'

9/28 5" @ 4414'

9/28 TD 4420'
Swb 6 bbls
oil PH

10/5 **Arb. 4413'**
5" @ 4414'
Pump 60 oil Pot.
TD 4420'
39.0 Gr.
Comp.

COMPLETED

Map No. _____ Sec. 33 Twp. 26 R. 13W

Well No. 2 Taylor

Sunray Company

Rine Drlg. Contractor

SE NW NW

FIRST REPORT
SECTION PLAT

990 Ft. from N. Line

_____ Ft. from S. Line

_____ Ft. from E. Line

990 Ft. from W. Line

Pratt County

Location _____

Rig up _____

Drilling and Remarks:

8" @ 795

drlg. 1630

RECORD

Cased _____ in., _____ ft.

Sand _____

Gas _____

Oil _____

Total Depth _____

PRODUCTION

1st 24 hrs. Nat. _____

1st 24 hrs. after shot _____

Gas _____ Cu. Ft.

Dry Hole _____

Abandoned _____

Date

AUG 31 1949 19 _____

S. J. LEWIS Scout

Map No. _____ Sec. 33 Twp. 26 R. 13W

Well No. 2 Taylor

Sunray

Company

COMPLETE

Contractor

SE NW NW

E. 1. 1960
SECTION PLAT

0			

990 Ft. from N. Line

_____ Ft. from S. Line

_____ Ft. from E. Line

990 Ft. from W. Line

Pratt County

Location _____

Rig up _____

Drilling and Remarks:

Ar 4413
5" @ 4417
Pump 60 oil pot
39° SW

RECORD

Cased _____ in., _____ ft.

Sand _____

Gas _____

Oil _____

Total Depth 4420

PRODUCTION

1st 24 hrs. Nat. _____

1st 24 hrs. after shot _____

Gas _____ Cu. Ft.

Dry Hole _____

Abandoned _____

Date

OCT 5 1949

19

S. J. LEWIS Scout