


KANSAS

O. W. P. B.
Pratt county

Section 33 Township 26 Range 13-W

Well No. #2, Jo. Lemon

Company ^{Oil}
Lion Chemical

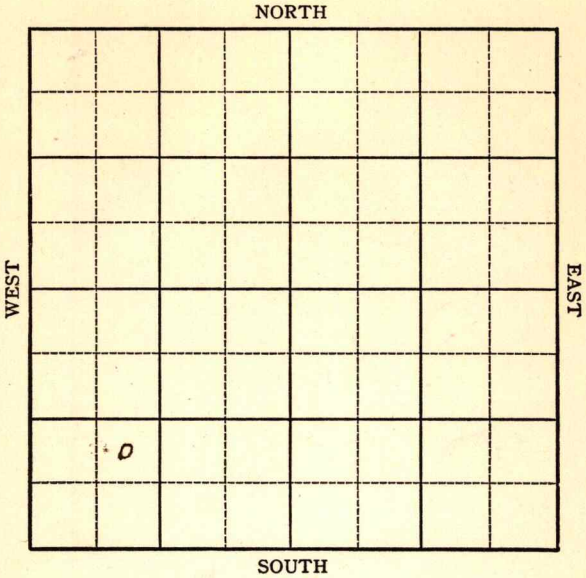

KANSAS

Pratt County

Sec. 33 Twp. 26 R. 13W

Well No. #2 Jo. Lemon Farm

Lion Chemical Company

Chance

O. W. P. B.


NORTH

Ft. from N. Line

990 Ft. from S. Line

Ft. from E. Line

990 Ft. from W. Line

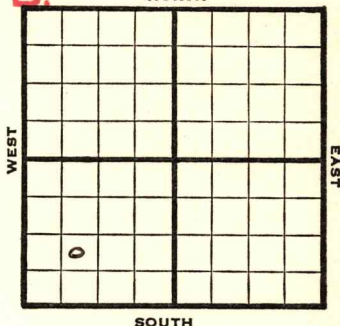

NE SW SW

1946 **Elev. 1968'** REPORT

9/11 RUR
9/18 8" @ 338'
Drlg 2445'
9/24 **Lans 3797'**
Drlg 4250'
10/1 **Lans 3789'**
Simp sd 4345'
Arb 4441
TD 4446
5" @ 4443'
10/8 Swb 30 oil plus 70 W in 8½ hrs
10/15 Plug 4309-60 shots 4346-56
1 B fluid PH 50% W.
10/22 Sqz Perf.
10/29 "
11/6 **Arb 4441'**
5" @ 4443'
Simp 4345'
Pump 32 oil plus 300 W POT
TD 4453'
Grav. 39

COMPLETED

OVER

1951

O. W. P. B.

3/7 Oil Well TD 4282
Viola 4263' Simp. sh 4339
Simp Sd 4345 Arb. 4441-53
5" @ 4443
SP 4340
47/4311-23 1000 A
S/wtr & SSO
SP 4302 48/4286-4302 1000 A
S/wtr & SSO
SP 4278 66/4252-76
SO 4268-76
S/3 $\frac{1}{2}$ boph 500 A S/wtr SP 4282
S/1 boph Comp. 10 bopd

FIRST REPORT
COMPLETED

Kansas Pool Name ChanceMap No. 83 Sec. 33 Twp. 26 R. 13WWell No. 2 Jo. LemonLion Chemical

Company

FIRST REPORT

Contractor

NE SW SW

SECTION PLAT

0			

 Ft. from N. Line990 Ft. from S. Line Ft. from E. Line990 Ft. from W. LinePratt CountyLocation Rig up

Drilling and Remarks:

R U R

RECORD

Cased in., ft.Sand Gas Oil Total Depth

PRODUCTION

1st 24 hrs. Nat. 1st 24 hrs. after shot Gas Cu. Ft.Dry Hole Abandoned

Date

9-111946S. J. LEWIS

Scout

Map No. 83 Sec. 33 Twp. 26 R. 13W

Well No. 2 Jo Lemon

Lion Chemical

Company


COMPLETED

Contractor

NE SW SW

E. 11/1963

SECTION PLAT

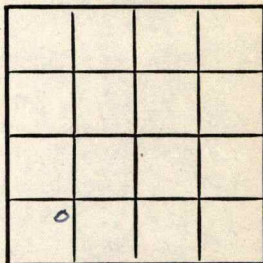

Ft. from N. Line

990 Ft. from S. Line

Ft. from E. Line

990 Ft. from W. Line

Pratt County

Location

Rig up

Drilling and Remarks:

Cr 4441

5' 10" 4442

Temp. 43.45

Prod 32 oil 7800W

Pat.

390

RECORD

Cased _____ in., _____ ft.

Sand _____

Gas _____

Oil _____

Total Depth 4453

PRODUCTION

1st 24 hrs. Nat. _____

1st 24 hrs. after shot _____

Gas _____ Cu. Ft.

Dry Hole _____

Abandoned _____

Date

NOV 6 1946 19

S. J. LEWIS

Scout

County Pratt State Kansas
 Sec. 33 (Blk.) 26 (Sur.) 13W Map No.
 Operator Lion Oil
 Well No. 2 Farm Jo
 Elev. 1968 Location NE SW SW

FIRST REPORT
COMPLETE

990 Ft. From S Line SW
990 Ft. From W Line Quarter
 1st. Report MAR 7 1951
 Completion MAR 7 1951
 Remarks OWPB
O.W.P.B.
 Spudding Date

Drlg. Data Oil well TD 4282
Viola 4263 Simp. sh. 4339 Simp. sd. 4345
Arb. 4441-53 5" @ 4443 SP 4340
47/ 4311-23 1000 A S/ water & SSO
SP 4302 48/ 4286-4302 1000 A S/ water
& SSO SP 4278 66/ 4252-76 SO 4268-76
S/ 3½ boph 500 A S/ water SP 4282
S/ 1 boph Comp. 10 bopd

J. E. TYRA