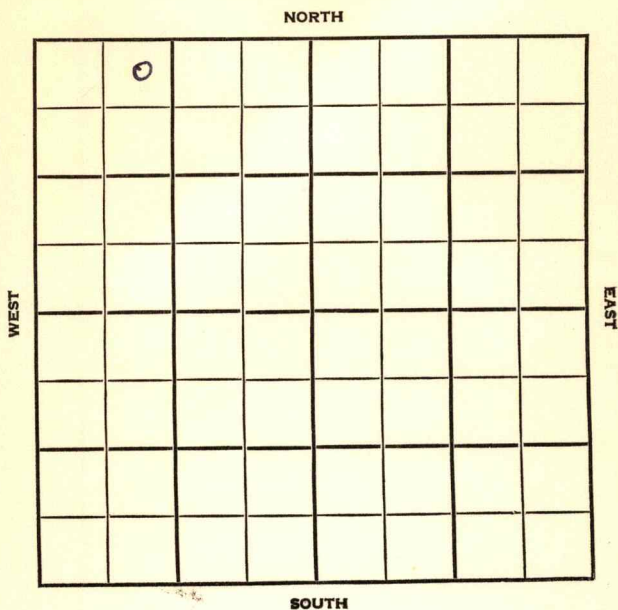


Section 33 Township 26S Range 13WWell No. 7 taylorCompany Sunray Mid-Continent

HOT FILE Pratt County KANSAS

SEC.	TWP.	R.
33	26 S	13 W

WELL NO. # 7 Taylor FARM

COMPANY Sunray-Mid-Continent

CONTRACTOR


330 Ft. from N. Line

Ft. from S. Line

Ft. from E. Line

660 Ft. from W. Line

N $\frac{1}{2}$ NW

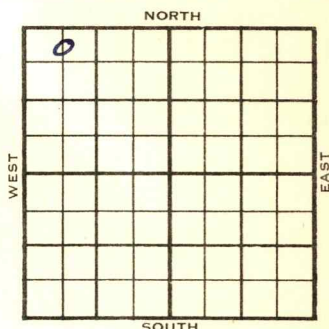

DATE	FORMATION	REPORT
1955	1952' KB	

5/19	TD 930' WOC -8-5/8" csg. (DR-99)
5/20	Drlg. 1910' (DR -100)
5/23	Drlg. 3095' (DR-101)
5/24	Drlg. 3445' (DR-102)
5/25	Drlg. 3748' (DR-103)
5/31	Drlg. 4375' DST 4270'-4320' Tool open 1' Rec 1515' gas 125' GCM BHFP 42# BHP 325#
5/26	Spud 5-15-55, 8 5/8" @ 928 w/1000 sx Heeb 3582, Br Lime 3746, Lans 3764, DST 3820-34, open 1 hr fair blow, rec 115' msw, FP 28-82#, BHP 1370# 20 min, Dring ahead
6/2	B KC 4089', Miss 4177, Simp 4322 DST 4170-4260, open 40 min, rec 170' GCM. BHP 451/20" DST 4270-4320, open 1 hr rec 1515' gyp 125' GCM, BHP 325/15". Drlg. 4375'

OVER

1955
6/9

Heeb 3582', Br. lime 3746',
Lans. 3764', B KC 4089', Miss 4177'
Simp. 4322', Arb. 4403'

RTD 4490'

DST 3820-34, open 1 hr rec 115' muddy
SW, 1370/20"

DST 4170-4260, open 40 min, rec 170'
GCM, 451/20"

DST 4270-4320, open 1 hr rec 1515'

GIP, 125' GCM, 325/15"

DST 4411-20 open 1 hr, rec 420' MSW

SSO, 1170/20". TD 4490'

D & A

ABANDONED

County Pratt Elev. 1949 RB
 Sec. 33 Twp. 26 Rge. 13W
 Company Sunray Oil Corp.
 Farm Name Taylor No. 7

TOPS	DEPTH	LOG	DATUM	Loc. in Sec.
Anh.				NE NW NW
TP.				
H.	3582		11633	
Tr.				
Dg.				
BL.	3746		1797	
L.	3764		1815	Geol.
K.C.				
B.K.C.	4089		2140	Contr.
Ce.				
C.				
M.	4177		2228	Pool
M.				Chance
K.				
Mz.				
Me.				
V.				
S.	4322		2373	
S.				
A.	4403		2454	
R.				
PE.				
G.				
TD.	4490			

Date Comm. 5-15-55 JUN 8 1955
8 5/8" @ 928/1000 DST 3820-34 open 1 hr
Rec. 115' muddy sw 1370/20" DST 4170-
4260 open 40 min. Rec. 170' gcm
451/20" DST 4270-4320 open 1 hr.
Rec. 1515' gip 125' gcm 325/15"
DST 4411-20 open 1 hr. Rec. 420' msw
1170/20" TD 4490

D & A