


Pratt

KANSAS

Section 34 Township 26 Range 13W

Well No. #1 Briggeman (C)

Company Rine Drlg.

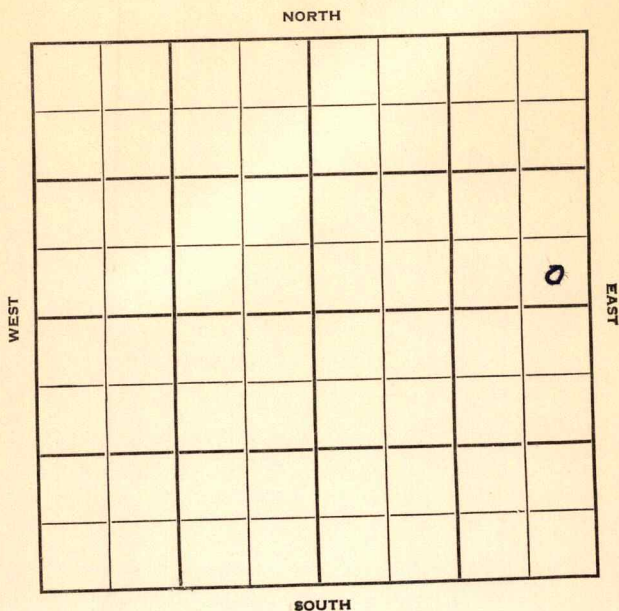

Sec. 34 Twp. 26 R. 13 W

Well No. # 1 Briggeman (C) Farm

Rine Drlg. Company

Rine Contractor


 Ft. from N. Line

330' Ft. from S. Line

330 Ft. from E. Line

 Ft. from W. Line

SE SE NE

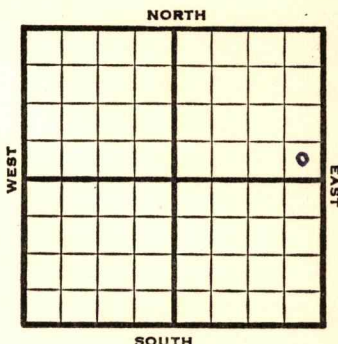

1952

Elev. 1941'

REPORT

8/6

Spud 8-4-52

Anhy 780'

8/13

Drlg. 3685'

8/20

Heeb. 3569 Br Li 3732

Lans. 3758 Drlg. 4309

8/27

Miss. 4138 KH 4190

V 4211 Simp. 4285

DST 4307-45, 1 hr. 2670' SW 1425#

Arb. 4382 RTD 4390 5" @ 4385'

24/ 4250-58' SO 24/ 4258-66

50' oil 24/ 4246-50 90' oil

23/4250-58 S/ 2½ Boph 500 A

S/ 10½ Boph 1500 A F 42 Boph

2½ hrs. F 50 BO 1 hr.

9/3

NR

9/10

Spud 8-4-52 Oil Well TD 4390'

8" @ 844'

Anhy 780

Heeb. 3569

Br Li 3732

Lans. 3758

DST 3775-3800 open 1 hr. rec. 90'

clean oil 180' muddy oil 65' ho&gcm

90' wtr. 1275#

DST 3971-95 open 1 hr. rec. 150' gcm

1300#

DST 4134-46 open ½ hr. rec. 15' mud

DST 4213-38 open 1 hr. rec. 900' gas

150' ocm 405#

OVER

1952

9/10

DST failed

DST 4248-95 open 1 hr. rec. 365' geo
1365#

Miss. 4138

Kh. 4190

Viola 4211

Simp. 4285

DST 4307-4345 open 1 hr. rec. 2670'
sw 1425#

Arb. 4382

TD 4390 5" @ 4385' 24/ 4250-58

24/ 4258-66 B/ 50' oil

24/ 4246-50 B/ 90' oil

23/ 4250-58 S/ 2½ boph 500 A

S/ 10½ boph 1500 A F/ 42 boph

F/ 50 boph

Comp. F/ 256 bopd

COMPLETED

County **Pratt** State **Kansas**Sec. **34** (Blk.) **26** (Sur.) **13W** Map No.Operator **Rine Drlg.**Well No. **1** Farm **Briggeman (C)**Elev. Location **SE SE NE**

FIRST REPORT

330 Ft. From **S** Line **NE****330** Ft. From **E** Line Quarter1st. Report **AUG 6 1952**


Completion

Remarks

Rine - Contr.Spudding Date **8-4-52**

Drlg. Data

Anhy 780**J. G. McGEHEE**

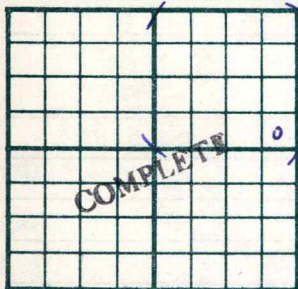County Pratt State KansasSec. 34 (Blk.) 26 (Sur. Rge.) 13W Map No.Operator Rine Drlg.Well No. 1 Farm Briggeman "C"Elev. 1941 Location SE SE NE330 Ft. From S Line NE330 Ft. From E Line Quarter

1st. Report

Completion SEP 10 1952

Remarks

Rine Drlg. - Contr.Spudding Date 8-4-52Drlg. Data Oil well TD 43908" @ 844 Anhy 780 Heeb. 3569Br. line 3732 Lans. 3758 DST 3775-3800open 1 hr. Rec. 90' clean oil 180'muddy oil 65' ho & gcm 90' wtr.1275# DST 3971-95 open 1 hr. Rec.150' gcm 1300# DST 4134-46 open $\frac{1}{2}$ hr.Rec. 15' mud DST 4213-38 open 1 hr.Rec. 900' gas 150' ocm 405# DST failedDS T 4248-95 open 1 hr. Rec. 365' gco1365# Miss. 4138 Kh. 4190 Viola 4211Simp. 4285 DST 4307-4345 open 1 hr.Rec. 2670' sw 1425# Arb. 4382TD 4390 5" @ 4385 24/ 4250-5824/ 4258-66 B/ 50' oil 24/ 4246-50

J. G. McGEHEE

Drlg. Data

B/ 90' oil 23/ 4250-58 8/ 2 $\frac{1}{4}$ boph
500 A S/ 10 $\frac{1}{2}$ boph 1500 A E/ 42 boph
F/ 50 boph Comp. F/ 256 boph

SEP 17 1952

