


Section 34 Township 26 Range 13W

Well No. #1 Drews

Company Welch & Olsson

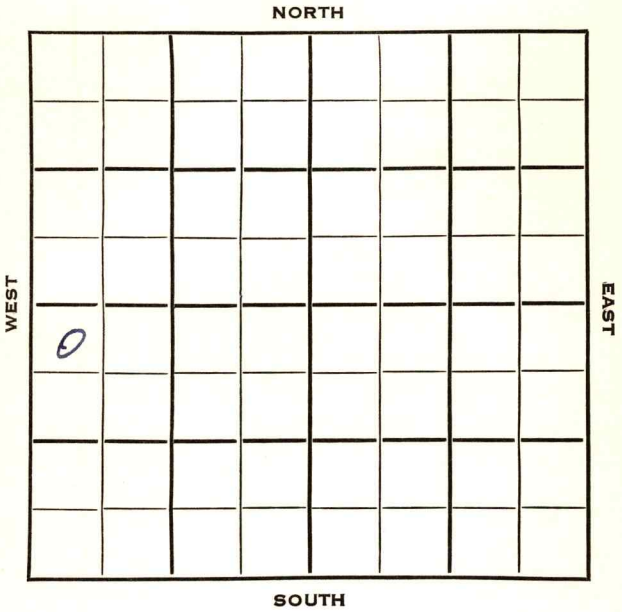


Sec. 34 Twp. 26 R. 13WWell No. #1 Drews FarmWelch & Olsson Company

Contractor

330 Ft. from N. Line

Ft. from S. Line

Ft. from E. Line

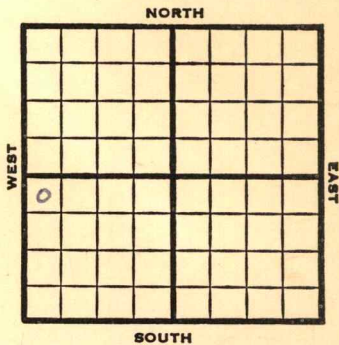330 Ft. from W. LineNW NW SW
Lion F/O

1953 Elev. 1947' REPORT

7/14 Spud 7-11-53
8" @ 813' w/440 sks

Anhy 889'

Drlg 1180'

7/22 Drlg 3520'

7/29 Heeb 3623 Br li 3779 Lans 3805

DST 4186-4216, 3/4 hr, 25' M

Miss 4231'

DST 4214-30, 1/2 hr, 15' M Off

KH 4253'

DST 4227-57, 1 hr, 1250' gas, 60' GCM
90#DST 4257-83, 1 hr, 2150' gas, 60' SO
& GCM 240#

8/5 Spud 7-11-53 D & A TD 4380

8" @ 813 Anhy 889 Heeb 3623

Doug 3662 Br lime 3779 Lans 3805

DST 4186-4216 open 3/4 hr rec 25' mud

Off Miss 4231

DST 4214-30 open 1/2 hr rec 15' mud Off

Kh. 4253

DST 4227-57 open 1 hr rec 1250' gas
60' GCM, 90#DST 4257-83 open 1 hr rec 2150' gas,
60' SO & GCM 240# Kh. 4253'

Viola 4309'

OVER

1953

8/5

(Information continued)

DST 4307-54 open $\frac{1}{2}$ hr rec 35' mud 0#

Simp 4361' TD 4380'

D & A

ABANDONED

County Pratt State Kansas

Sec. 34 (Blk.) 26 (Sur.) 13W Map No.

Operator Welch & Olsson

Well No. 1 Farm Drews

Elev. 1947 Location NW NW SW

330 Ft. From N Line SW

330 Ft. From W Line Quarter

1st. Report

Completion AUG 5 1953

Remarks

Spudding Date 7-11-53

Drlg. Data D & A TD 4380

8" @ 813 Anhy 889 Heeb. 3623

Doug. 3662 Br. lime 3779 Lans. 3805

DST 4186-4216 open 3/4 hr. Rec. 25' mud

O# Miss. 4231 DST 4214-30 open 1/2 hr.

Rec. 15' mud O# Kh. 4253 DST 4227-57

open 1 hr. Rec. 1250' gas 60' gcm 90#

DST 4257-83 open 1 hr. Rec. 2150' gas

60' so & gcm 240# Kh. 4253

Viola 4309 DST 4307-54 open 1/2 hr.

Rec. 35' mud O# Simp. 4361 TD 4380

D & A

County **Pratt** State **Kansas**

Sec. **34** (Blk. Twp.) **26** (Sur. Rge.) **13W** Map No.

Operator **Welch & Olsson**

Well No. **1** Farm **Drews**

Elev. Location **NW NW SW**

330 Ft. From **N** Line **SW**

330 Ft. From **W** Line Quarter

1st. Report **JUL 14 1953**

Completion

Remarks **Lion - FO**

Spudding Date **7-11-53**

Drlg. Data

8" @ 813 w/440 Anh 889, Drlg. 1180

J. G. McGEHEE