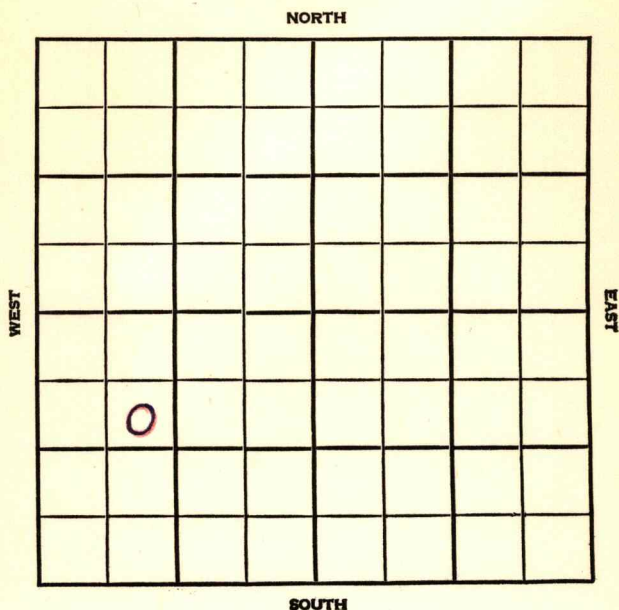


Section 35 Township 26 Range 13WWell No. #2 Briggeman "B"Company Rine Drlg.

Pratt

KANSAS

SEC.	TWP.	R.
35	26	13W

WELL NO.

2 Briggeman "B"

FARM

COMPANY

Rine Drlg

CONTRACTOR

Peel

Iuka-Carmi Pool


990' Ft. from N. Line

Ft. from S. Line

Ft. from E. Line

990' Ft. from W. Line

SE NW SW

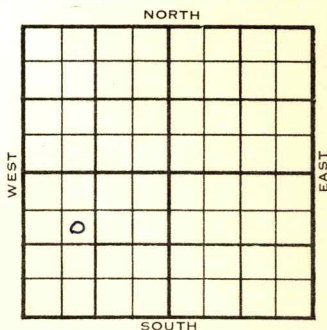

1955

ELEVATION

1937'

REPORT

5/25

Spud 5-10-55

13" @ 251

8" @ 1202

Drlg 1221

6/29

Spud 5-10-55

H 3570

B1 3736

L 3765

BKC 4085

M 4177

K 4191

V 4234

S 4281

A 4388

TD 4430

13" @ 251 8" @ 1202

DST 3908-25 open 1 hr Rec 630' gas

65' socm 416/20" DST 3987-99

open 1 hr Rec 30' mud 95/30"

DST 4039-72 open 1 hr Rec 30' mud

840/30" DST 4198-4218 open 1 hr.

Rec 300' gas 30' so & gcm 135/20"

DST 4231-55 open 1 hr Rec 65' mud

263/30"

OVER

1955

6/29 DST 4255-85 open 1 hr Rec 2700' gas
185' hocm 540' socsw 827/20"
DST 4280-4320 open 1 hr. gas in 20
min. Rec 130' ho & gcm 180' mgo
65' clean gassy oil 1050/30"
DST 4390-4400 open 1 hr Rec 30'
socm 190/30" 5 1/2" @ 4391
CO to 4402 SP 4376 24/4296-4300
24/4300-04 25/4305-09 1 1/2 boph
500 A F/10 boph P/47 bo 12 hr
P/60 bo 24 hr
Comp 85 bopd

COMPLETED

County Pratt State KansasSec. 35 (Blk.) 26 (Sur.) 13W Map No.Operator Rine Drlg.Well No. 2 Farm Briggeman "B"Elev. Location SE NW SW

FIRST REPORT


990 Ft. From N Line SW

990 Ft. From W Line Quarter

1st. Report MAY 25 1955

Completion

Remarks

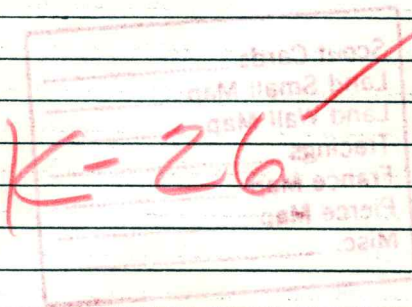Peel - Contr.Spudding Date 5-10-55Drlg. Data Iuka-Carmi Pool13" @ 251 8" @ 1202 drlg.1221

County Pratt Elev. 1937
 Sec. 35 Twp. 26 Rge. 13W
 Company Rine Drlg.
 Farm Name Briggeman "B" No. 2

TOPS	DEPTH	LOG	DATUM	Loc. in Sec.
Anh.				SE NW SW
Tr.				
H.	3570		1633	
Tr.				
Dg.				
BL.	3736		1799	
L.	3765		1828	Geol.
K.C.				
B.K.C.	4085		2148	Contr.
Ce.				
C.				Peel
M.	4177		2240	
M.				Pool
K.	4191		2254	Iuka-Carmi
Mz.				
Mo.				
V.	4234		2297	
S.	4281		2344	
S.				
A.	4388		2451	
R.				
P.C.				
G.				
T.D.	4430			



Date Comm. 5-10-55 JUN 29 1955
 13" @ 251 8" @ 1202 DST 3908-25
 open 1 hr. Rec. 630' gas 65' socm
 416/20" DST 3987-99 open 1 hr. Rec.
 30' mud 95/30" DST 4039-72 open 1 hr
 Rec. 30' mud 840/30" DST 4198-4218
 open 1 hr. Rec. 300' gas 30' so & gcm
 135/20" DST 4231-55 open 1 hr. Rec.
 65' mud 263/30" DST 4255-85 open 1 hr

Rec. 2700' gas 185' hocm 540' socsw
827/20" DST 4280-4320 open 1 hr. gas
in 20 min. Rec. 130' ho & gcm 180' mgo
65' clean gassy oil 1050/30" DST 4390-
4400 open 1 hr. Rec. 30' socm 190/30"
5 $\frac{1}{2}$ " @ 4391 CO to 4402 SP 4376
24/ 4296-4300 24/ 4300-04 25/ 4305-09
1 $\frac{1}{2}$ boph 500 A F/ 10 boph
P/ 47 bo 12 hr. P/ 60 bo 24 hr.
Comp. 85 bopd

_____	Misc.
_____	Pierce Map
_____	France Map
_____	Tracings
_____	Land Wall Map
_____	Land Small Map
_____	Scout Cards

W W W

JUL 8 1955