Pratt


DX 78-1

KANSAS

Section 35 Township 26S Range 13W

Well No. #3 Hoener

Company Rine Drlg. Co.

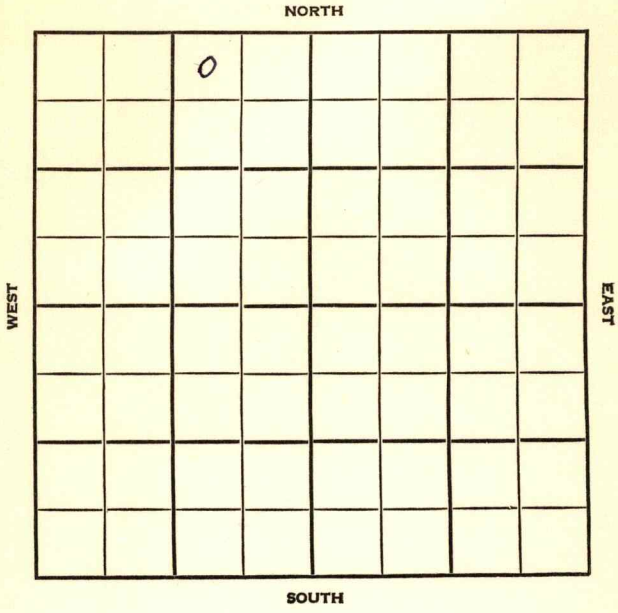

Pratt KANSAS

SEC.	TWP.	R.
35	26S	13W

WELL NO. #3 Hoener FARM

COMPANY Rine Drlg.Co.

CONTRACTOR Peel Tools.

Chance E.


330 Ft. from N. Line

Ft. from S. Line

990 Ft. from E. Line

Ft. from W. Line

NW NE NW

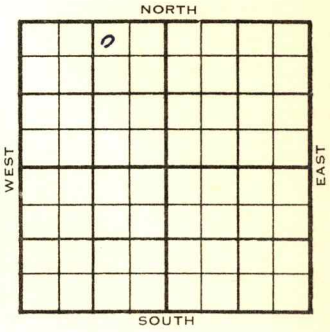

1954	ELEVATION 1942' REPORT
12/8	Spud 11-26-54 Anhy 760' 8" @ 1203' Heeb 3551', Br. Ls. 3715', Lans 3739' DST 3763'-78' 1 hr, G N 4" R 80 ' M FP 85-110 BHP 405/20" DST 3935'-49' 1 hr, GN 40", R 65' SO&GCM 60' HO&GCM, 40' oil, 20' W BHP 971 Drlg. 3955'
1955 1/12	Spud 11-26-54 - Oil Well TD 4348' Anhy 760' 8" @ 1203' Heeb. 3551', Br lime 3715', Lans 3739' DST 3763-78', opn 1 hr., rec. 80' mud, 405# DST 3935-49', opn 1 hr., rec. 65' SO& GCM, 60' HO&GCM, XXX 40' oil,20' wtr, 971# B KC 4057', Miss. 4152', Kh. 4162', Viola 4187'

OVER

DX-78

(Information Brought Forward)

1955
1/12 DST 4179'-4213', opn 1 hr., rec. 1400' gas, 90' GCM, 315#
Simp. 4226'
DST 4230-64', opn 1 hr., 277,000 cfg, 1 hr., rec. 70' gcm, 1315#
Arb. 4321'
DST 4323-40', opn 1 hr., rec. 3700' gas, 31' HOCM, 126' muddy oil, 126' clean oil, 1400#
TD 4340'
5" @ 4326'
DD 4348'
S/45 bopd
Comp. 169 bopd

COMPLETED

FORM 275 FOR SALE BY KANSAS BLUE PRINT CO.


County Pratt State Kansas

Sec. 35 (Blk. Twp.) 26S (Sur. Rge.) 13W Map No.

Operator Rine Drlg Co.

Well No. 3 Farm Hoener

Elev. Location NW NE NW

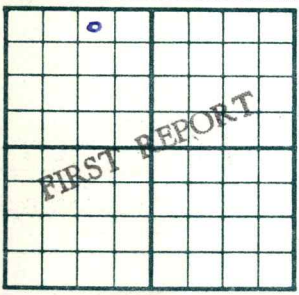

330 Ft. From N Line

990 Ft. From E Line NW Quarter

1st. Report DEC 8 1954

Completion

Remarks Peel tools

Spudding Date 11-26-54

Drlg. Data Chance E.

Anh 760, 8" @ 1203 Heeb 3551, Br Ls 3715, Lans 3739, DST 3763-78 1 hr G N 4" R 80' M, FP 85-110, BHP 405/20", DST 3935-49 1 hr GN 40", R 65' SO&GCM, 60' HO&GCM, 40'oil 20'W, BHP 971, Drlg 3955

FABEN GILSTRAP

FORM 275 FOR SALE BY KANSAS BLUE PRINT CO.

County Pratt State Kansas

Sec. 35 (Blk. Twp.) 26 (Sur. Rge.) 13W Map No.

Operator Rine Drlg.

Well No. 3 Farm Hoener

Elev. 1942 Location NW NE NW



330 Ft. From N Line NW

990 Ft. From E Line Quarter

1st. Report

Completion JAN 1 2 1955

Remarks E. Chance Pool

Peel - Contr.

Spudding Date 11-26-54

Drlg. Data Oil well TD 4348

Anhy 760 8" @ 1203 Heeb. 3551

Br. lime 3715 Lans. 3739 DST 3763-78

open 1 hr. Rec. 80' mud 405#

DST 3935-49 open 1 hr. Rec. 65' so & gcm

60' ho & gcm 40' oil 20' wtr. 971#

B KC 4057 Miss. 4152 Kh. 4162

Viola 4187 DST 4179-4213 open 1 hr.

Rec. 1400' gas 90' gcm 315#

Simp. 4226 DST 4230-64 open 1 hr.

277,000 cfg 1 hr. Rec. 70' gcm 1315#

Arb. 4321 DST 4323-40 open 1 hr.

Rec. 3700' gas 31' hocm 126' muddy oil

126' clean oil 1400# TD 4340 5" @ 4326

DD 4348 S/45 bopd Comp. 169 bopd

FABEN GILSTRAP