


Section 33 Township 26 Range 13-W

Well No. #2 Joe

Company Rine Drlg.

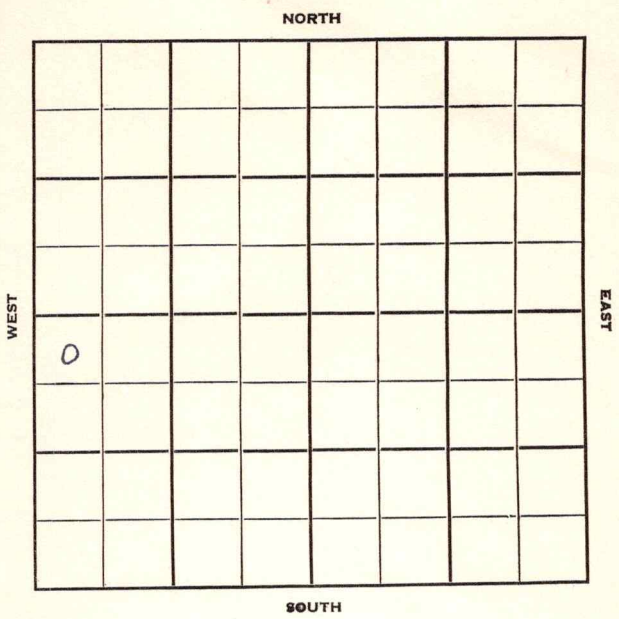

Pratt

KANSAS

Sec. 33 Twp. 26 R. 13W ✓

Well No. #2 Joe Farm

Rine Drlg. Company

Rine Drlg. - Contr. Contractor

Chance Pool


330' Ft. from N. Line

Ft. from S. Line

Ft. from E. Line

330' Ft. from W. Line

NW NW SW

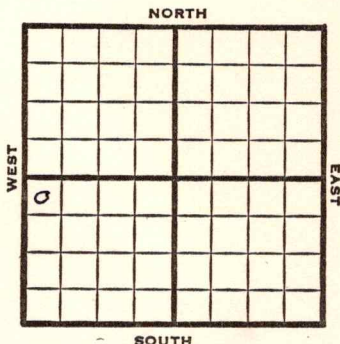

1950

Elev 1965' REPORT

11/1

Spud 10-27-50
8-5/8" @ 785'
Drlg. 2105'

1951
1/10

Spud 10-27-50
8 5/8" @ 785'
Heeb 3628 Br lime 3778
Lans 3802
DST 3830-50 opn 1 hr rec 55' gcm SSO
DST 3950-76 opn 1/2 hr rec 31' gcm
Cong 4214 Kinderhook 4228
Viola 4240
DST 4296-4329 opn 1/2 hr rec 100' ocm
1260' free oil
Simp 4342
DST 4341-54 opn 45 min rec 210' ocm
120' water
Arb 4430
TD 4434
5 1/2" @ 4432
2 boph DD 4435
S/5 boph 500 A S/8 boph
P/56 bopd P/48 bopd
P/38 bopd 1500 A
Comp 35 bopd 70 bw
Completed TD 4435'

COMPLETED

County Pratt State KansasSec. 33 (Blk.) 26 (Sur.) 13W Map No.Operator Rine Drlg.Well No. 2 Farm JoeElev. Location NW NW SW

0							

330 Ft. From N Line SW330 Ft. From W Line Quarter1st. Report NOV 1 1950

Completion

Remarks

Rine Drlg. - Contr.Spudding Date 10-27-50Drlg. Data Chance Pool8 5/8" @ 785 drlg. 2105

J. E. TYRA