

KANSAS

Pratt


Section 33 Township 26 Range 13W

Well No. 1 Jo

Company Rine Drlg.

Chance
NORTH

WEST

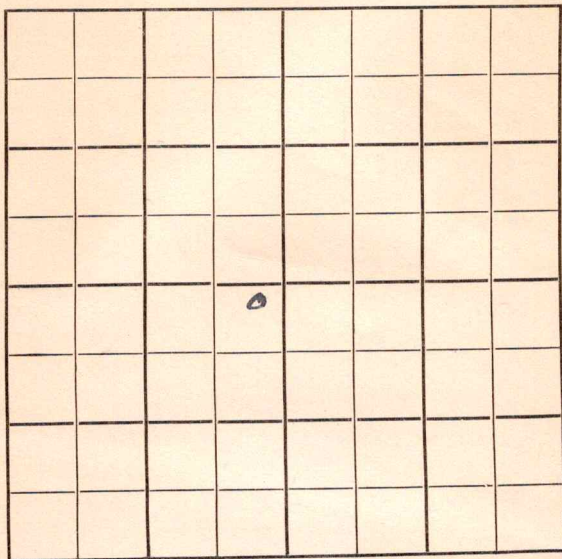

EAST

SOUTH

Pratt

KANSAS

Sec. 33 Twp. 26 R. 13W

Well No. #1 Jo Farm

Rine Drlg.

Chance Pool (Rine Drlg., Cont.) Company

NORTH


330' Ft. from N. Line

 Ft. from S. Line

330' Ft. from E. Line

 Ft. from W. Line

NE SW

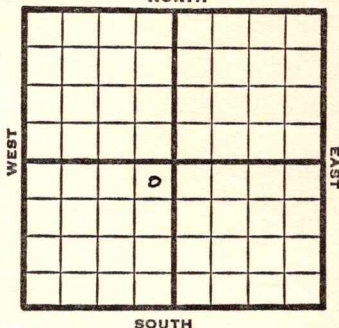

1949

^B lev 1960'

R E P O R T

9/21

Drlg. 800'

9/28

10" @ 300'

8" @ 878

Drlg 1404'

10/5

Drlg 4062'

10/12

Lansing 3792'

Viola 4242'

Simpson sd 4352'

Arbuckle 4432-36'

TD 4436'

5" @ 4432'

10/19

TD 4437'

Arb. 4432'

5" @ 4432'

500 acid

Pump 50 Oil Pot

40° Gr.

Comp

COMPLETED

Map No. _____ Sec. 33 Twp. 26 R. 13W

Well No. 1 Jo

Rine Drlg. _____ Company _____

Rine Drlg. _____ Contractor _____

NE SW


**FIRST REPORT
SECTION PLAT**

330 Ft. from N. Line

_____ Ft. from S. Line

330 Ft. from E. Line

_____ Ft. from W. Line

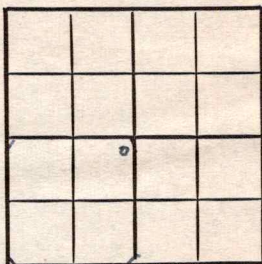

Pratt County

RECORD

Location _____

Cased _____ in., _____ ft.

Rig up _____

Sand _____

Drilling and Remarks:

Gas _____

drlg. 800

Oil _____

Total Depth _____

PRODUCTION

1st 24 hrs. Nat. _____

1st 24 hrs. after shot _____

Gas _____ Cu. Ft.

Dry Hole _____

Abandoned _____

Date

SEP 21 1949 19

S. J. LEWIS Scout

Kansas

Chance Pool

Map No. _____ Sec. 33 Twp. 26 R. 13WWell No. 1 Jo

Rine Drlg. _____ Company

COMPLETE

Contractor

NE SW

E11960
SECTION PLAT330 Ft. from N. Line

_____ Ft. from S. Line

330 Ft. from E. Line

_____ Ft. from W. Line

	6		

Pratt County

Location _____

Rig up _____

Drilling and Remarks:

Per 4432
5" @ 4432
5000 ad
Run 5000 ft

40 2 1/2

RECORD

Cased _____ in., _____ ft.

Sand _____

Gas _____

Oil _____

Total Depth 4437

PRODUCTION

1st 24 hrs. Nat. _____

1st 24 hrs. after shot _____

Gas _____ Cu. Ft.

Dry Hole _____

Abandoned _____

Date

OCT 19 1949

19

S. J. LEWIS Scout