



Sec. 33 Twp. 26 R. 13W

Well No. #5 Jo Farm \_\_\_\_\_

Rine Drlg. Company \_\_\_\_\_

Prime Drlg. Contractor \_\_\_\_\_

Chance Pool


990 Ft. from N. Line

\_\_\_\_\_ Ft. from S. Line

\_\_\_\_\_ Ft. from E. Line

330 Ft. from W. Line

SW NW SW

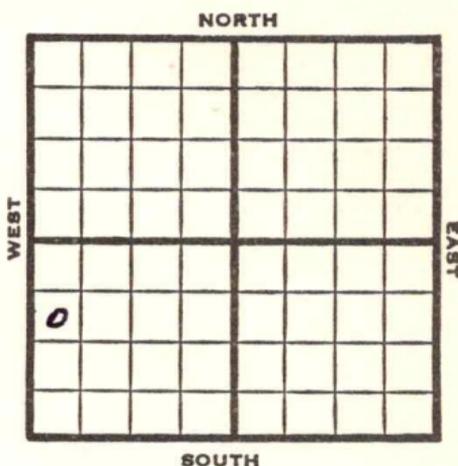

1953 **Elev. 1964'** REPORT

1/14 Spud 1-11-53  
8" @ 847'

1/22 Drlg. 3975'

1/29 NR

2/5 "

2/12 "

2/19 "

2/26 " "

3/12 NR

3/20 Spud 1-11-53 Oil well TD 4470'  
8" @ 847'  
DST 3819-42, open 1 hr. rec 90' GCM  
**Heeb 3625 Br. lime 3776' Lans 3801**  
DST 3961-75 open 3/4 hr. rec 20' mud  
15#  
DST 3987-4010 open 1 hr. rec 60' VSGCM  
345# **Miss 4198'**  
DST 4192-4210 open 3/4 hr. rec 10' mud  
30# **Kh. 4244'**  
DST 4250-70 open 1 hr. rec 90' O & GCM  
1180# **Viola 4302'**  
DST 4291-4340 open 1 hr. rec 1670' cl  
oil, 1150# **Simp. 4342'**  
DST 4375-87 open 1 hr. rec 20' mud  
70#

**OVER**

1953  
3/18

(Information continued)

Arb. 4432' TD 4480' 5" @ 4470  
CO to 4470 95/4310-30 S/2 BOPH  
6 hr. 500 A S/10 BOPH 6 hr.  
Sd-frac. S/15 BOPH 8 hr.  
p/10 BOPH Went to 75% wtr. Sq.  
CO to 4324' 48/4306-14 32/4314-18  
A-frac.  
Comp. 153 BOPD ~~11%~~ 11% wtr.

**COMPLETED**





Drig. Data

S/ 15 boph 8 hr. P/ 10 boph went to  
75% wtr. sq. CO to 4324 48/ 4306-14  
32/ 4314-18 A-frac Comp. 153 bopd 11% wt

Scout Cards	<i>mm</i>
Land Small Map	
Land Well Map	
Tracings	
France Map	
Pierce Map	
Map	

MAR 24 1953