


Section 35 Township 26 Range 13W

Well No. #1 Hoener "B"

Company Rine Drlg.

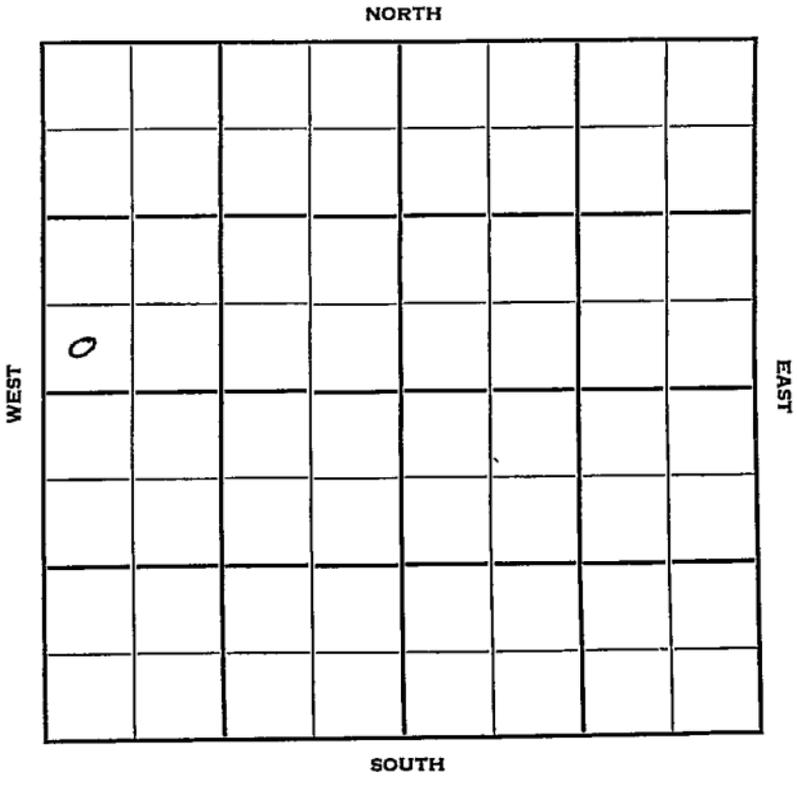

Sec. 35 Twp. 26 R. 13W

Well No. #1 Hoener "B" Farm

Rine Drlg. Company

It \_\_\_\_\_ Contractor


\_\_\_\_\_ Ft. from N. Line

330 Ft. from S. Line

\_\_\_\_\_ Ft. from E. Line

330 Ft. from W. Line

SW SW NW

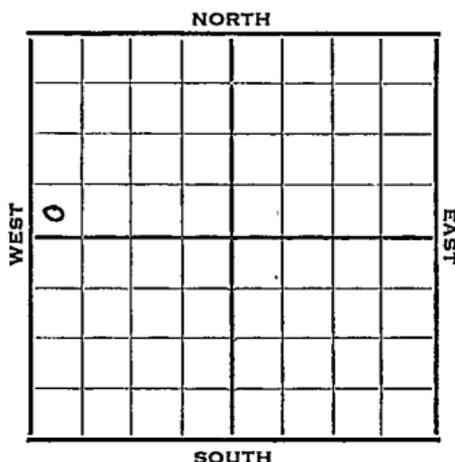

1952	Elev. 1941'	REPORT
9/24	Spud 9-17-52 8" @ 1214' Drlg. 2740'	
10/1	Tarkio 2903 Heeb 3569 Lans. 3756 DST 3770-3800, 1 hr. 135' SO&GCM & 945' gas 125# Drlg. 3930'	Topeka 3192 Br Li 3727
10/8	DST 3969-95 open 1 hr. rec. 930' gas 60' SO&GCM 90' wtr. DST 3999-4022 open 1 hr. rec. 30' mud Miss. 4134 DST 4132-46 open 1 hr. rec. 15' mud Kh. 4173 DST 4176-78 open 1 hr. rec. 45' mud DST 4187-4211 open 1 hr. rec. 90' OCM & 30' oil Viola 4232 DST 4228-65 open 1 hr. rec. 100' SO&GCM 120' HOCM Simp. 4273 DST 4272-4312 open 45 min. rec. 100' SGCM Arb. 4376	
10/15	TD 4384' 5" @ 4380' DD 4399 TD N/S PB 4350 23/4286-94 N/S PB 4280 70/4246-62, 500A, S/9 BOPH, BOP	

OVER

1952.  
10/22 No report  
10/29 P/85 BOPD for 3 days  
L1/5 NR  
11/12 Spud 9-17-52  
Oil Well  
TD 4399'  
8" @ 1214  
Tarkio 2903, Top. 3192, Heeb  
3569, Br. lime 3727, Lans 3756,  
DST 3770-3800, opn 1 hr., rec.  
135' so & gcm 945' gas 125#  
DST 3969-95, opn 1 hr., rec.  
930' gas, 60' so & gcm 90' wtr  
DST 3999-4022, opn 1 hr., rec.  
30' mud  
Miss 4134  
DST 4132-46, opn 1 hr., rec.  
15' mud  
Kh. 4173  
DST 4176-78, opn 1 hr., rec. 45'  
mud  
DST 4187-4211, opn 1 hr., rec.  
90' ocm 30' oil  
Viola 4232  
DST 4228-65, opn 1 hr., rec.  
100' so & gcm, 120' hocm  
Simp. 4273  
DST 4272-4312, opn 45 mins.  
rec. 100' sgcm  
Arb. 4376  
TD 4384  
5" @ 4380  
DD 4399 wtr PB 4350  
23/4286-94, PB 4280 70/4246-62  
500A S/9 boph P/85 bopd  
Comp. 83 bopd

**COMPLETED**



Drig. Data

Rec. 100' sgcm Arb. 4376 TD 4384

5" @ 4380 DD 4399 wtr. PB 4350

23/ 4286-94 PB 4280 70/ 4246-62

500 A S/ 9 boph P/ 85 bopd

Comp. 83 bopd

Scout Cards
Land Small Map
Land Wall Map
Tracings
France Map
Pierce Map
Misc.

*DD*

NOV 19 1957

County Pratt State Kansas

Sec. 35 (Blk. Twp.) 26 (Sur. Rge.) 13W Map No.

Operator Rine Drlg.

Well No. 1 Farm Hoener "B"

Elev. 1941 Location SW SW NW

0							

330 Ft. From S Line NW

330 Ft. From W Line Quarter

Ist. Report SEP 24 1952

Completion \_\_\_\_\_

Remarks \_\_\_\_\_

Rine Drlg. - Contr.

Spudding Date 9-17-52

Drlg. Data \_\_\_\_\_

8" @ 1214 drlg. 2740