DX 78-1


KANSAS

Pratt

Section 35 Township 26 Range 13W

Well No. #4 Hoener "B"

Company Rine Drlg.

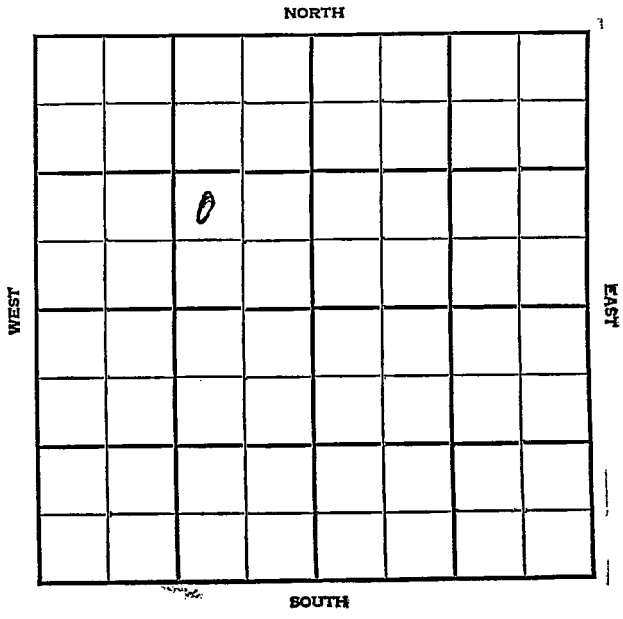

Pratt KANSAS

| SEC. | TWP. | R. |
|---|---|---|
| 35 | 26 | 13W |

WELL NO.

4 Hoener "B" FARM


COMPANY

Rine Drlg.

CONTRACTOR

Rine Drlg.

Iuka-Carmi

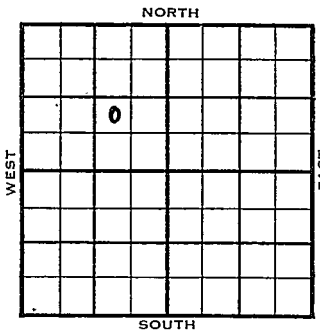


_____ Ft. from N. Line

_____ Ft. from S. Line

_____ Ft. from E. Line

_____ Ft. from W. Line

NW SE NW

1955 ELEVATION /933' REPORT

6/15 Comm 6-9-55
8" @ 1200
Drlg 1740

COMPLETED

7/13 DST 4203-35 open 1 hr. Rec. 660' gas 80' vso & gcm 280/20" DST 4225-51 open 1 hr. gas in 10 min. Rec 260' muddy oil 60' free oil 1290/30" DST 4251-95 open 1 hr. Rec 519' mud 367 mcfg in 60 min Rec. 80' so & gcm 150' muddy oil 90' fr free oil 1038/30" 5½" @ 4372/200 CO to 4385 1 bwph PB 4330 80/4225-45 FU 300' oil 2½hr. 500 A S/10 boph F/90 bo Comp F/140 bopd

| Tops: | Depth | Datum |
|---|---|---|
| H. | 3558 | 1635 |
| BL. | 3722 | 1789 |
| L. | 3749 | 1816 |
| BKC | 4070 | 2137 |
| M. | 4170 | 2237 |
| K, | 4185 | 2252 |
| V | 4205 | 2272 |
| S: | 4252 | 2319 |
| A. | 4365 | 2432 |
| TD. | 4385 | |

DX-78

FORM 513 REV. SUNRAY

County Pratt Elev.

Sec. 35 Twp. 26 Rge. 13W

Company Rine Drlg.

Farm Name Agener "B" No. 4

| TOPS | DEPTH | LOG | DATUM |
|---|---|---|---|
| Anh. | | | |
| Tp. | | | |
| H. | | | |
| Tr. | | | |
| Dg. | | | |
| Bl. | | | |
| L. | | | |
| K.C. | | | |
| B.K.C. | | | |
| Ce. | | | |
| C. | | | |
| M. | | | |
| M. | | | |
| K. | | | |
| Mz. | | | |
| Mo. | | | |
| V. | | | |
| S. | | | |
| S. | | | |
| A | | | |
| R. | | | |
| Pe. | | | |
| G. | | | |
| T.D. | | | |

Loc. in Sec. NW SE NW

Geol.

Contr. Rine D lg.

Pool Tyler-Cermi

FIRST REPORT
JUN 15 '55

Date Comm. 6-9-55

8" @ 1200 drlg. 1740

K-26

FORM 513 REV. SUNRAY

County Pratt Elev. 1933

Sec. 35 Twp. 2 6 Rge. 13W

Company Rine Drlg.

Farm Name Hoener "B" No. 4

| TOPS | DEPTH | LOG | DATUM |
|---|---|---|---|
| Anh. | | | |
| T.P. | | | |
| H. | 3558 | | 1635 |
| Tr. | | | |
| Dg. | | | |
| B.L. | 3722 | | 1799 |
| L. | 3749 | | 1816 |
| K.C. | | | |
| B.K.C. | 4070 | | 2137 |
| Ce. | | | |
| C. | | | |
| M. | 4170 | | 2237 |
| M. | | | |
| K. | 4185 | | 2252 |
| Mz. | | | |
| Mg. | | | |
| V. | 4205 | | 2272 |
| S. | 4252 | | 2319 |
| S. | | | |
| A | 4365 | | 2432 |
| R. | | | |
| P€. | | | |
| G. | | | |
| T.D. | 4385 | | |


Loc. in Sec. NW SE NW

Geol.

Contr. Rine Drlg.

Lse.

Pool Iuka-Carmi

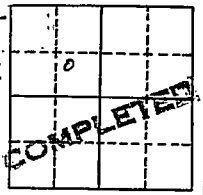


No.

Date Comm. 6-9-55

JUL 13 1955

Sec.

8" @ 1200 DST 4203-35 open 1 hr.

Rec. 660' gas 80' vso & gcm

280//20" DST 4225-51 open 1 hr.

gas in 10 min. Rec. 360' muddy oil

60' free oil 1390/30" DST 4251-95

open 1 hr. Rec. 519' mud 367 mcfg in

60 min. Rec. 80' so & gcm 150' muddy

oil 90' free oil 1038/30"

T.

R.


OVER

5½"@ 4372/200 CO to 4385 1 bwph

PB 4330 80/ 4225-45 FU 300' oil 2½ hr.

500 A S/ 10 boph F/ 90 bo

Comp. F/ 140 bopd

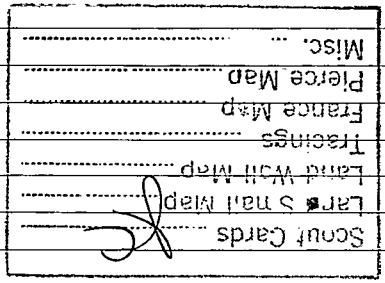


JUL 25 1955