

KANSAS

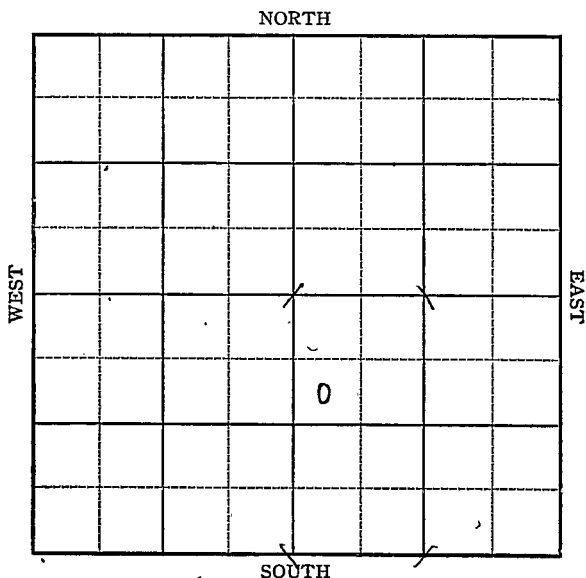
FORM 51 5M PETROL

Pratt

Section 36 Township 26 Range 13-W

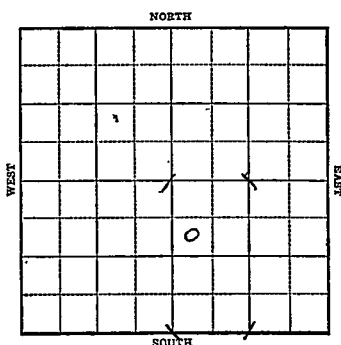
Well No. #1 Beck "F"

Company Bridgeport Oil



KANSAS

Pratt

Sec. 36 Twp. 26 R. 13-WWell No. #1 Beck "F" FarmBridgeport Oil Company990 Ft. from N. Line Ft. from S. Line Ft. from E. Line330 Ft. from W. LineElev. 1929

1943

R E P O R T

10/27 Location

11/3 "

11/10 "

11/17 "

11/24 "

12/1 "

12/8 "

12-15 8" at 452' WOC

12/22 Anhy 764

Drlg. 2352

12/29 Drlg 3447'

1944

1-5 Miss 4157

Kind 4180

Drlg 4283'

1/12 Arb 4351

TD 4395

Water

4351
1929

-2422

ABANDONED

KANSAS

3

Map No. 8 Sec. 36 Twp. 26 R. 13WWell No. 1 Beck "F"Bridgeport Oil

Company

FIRST REPORT

Contractor

SW NW SE

990

Ft. from N. Line

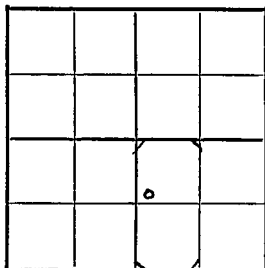
Ft. from S. Line

Ft. from E. Line

330

Ft. from W. Line

SECTION PLAT

Carmi PoolLocation X

Rig up

Drilling and Remarks:

RECORD

Cased _____ in., _____ ft.

Sand _____

Gas _____

Oil _____

Total Depth _____

PRODUCTION

1st 24 hrs. Nat. _____

1st 24 hrs. after shot _____

Gas _____ Cu. Ft.

Dry Hole _____

Abandoned _____

Date

OCT 27 1943

19

S. J. LEWIS

Scout

KANSAS

Map No. 83 Sec. 36 Twp. 26 R. 13WWell No. 1 Beck "B"Bridgeport Oil CompanyABANDONED Contractor

SW NW SE

SECTION PLAT

990 Ft. from N. Line

Ft. from S. Line

Ft. from E. Line

330 Ft. from W. LineCarmi Pool

Location

Rig up

Drilling and Remarks:

CR 44851
Water

RECORD

Cased in, ft.

Sand

Gas

Oil

Total Depth 4325

PRODUCTION

1st 24 hrs. Nat.

1st 24 hrs. after shot

Gas Cu. Ft.

Dry Hole

Abandoned

Date

JAN 12 1944 19 S. J. LEWIS Scout