


Section 36 Township 26 Range 13W

Well No. #1 Beck

Company McKnab Drlg.

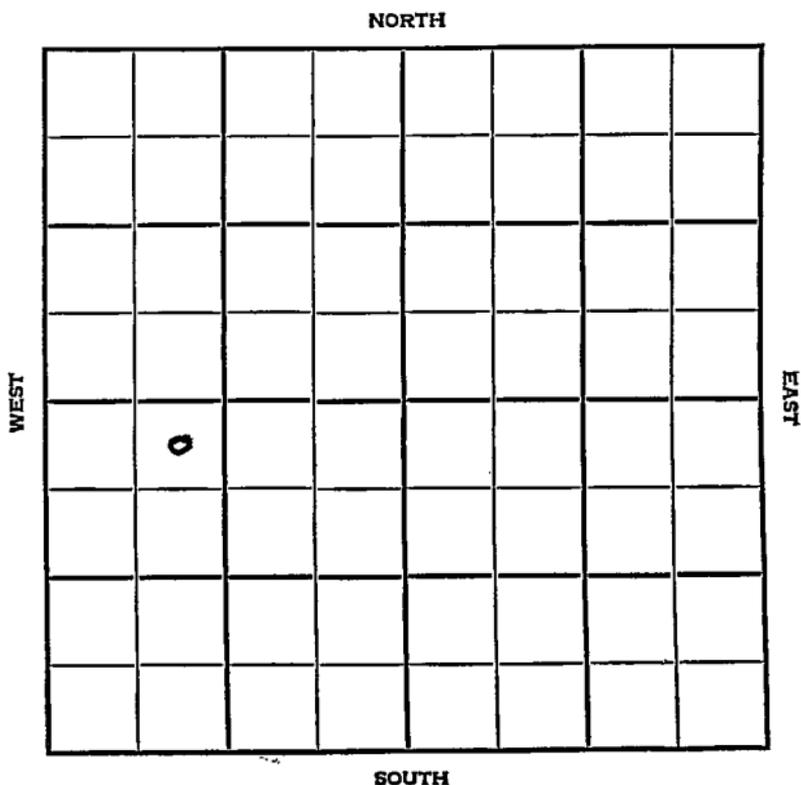

Pratt KANSAS

SEC:	TWP.	R.
36	26	13W

WELL NO. 1 Beck FARM  
 COMPANY

CONTRACTOR McKnab Drlg.


Co. Tools Iuka-Carmi Pool

330 Ft. from N. Line

Ft. from S. Line

Ft. from E. Line

990 Ft. from W. Line

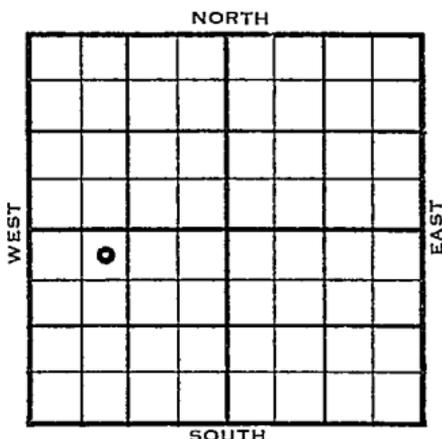

NE NW SW

	ELEVATION	REPORT
1955	1924'	

4/6 Spud 4-1-55  
 8" @ 455'  
 Drlg. 1200'

4/20 Spud 4-1-55 - D&A  
 TD 4370'  
 8" @ 455'  
 Heeb. 3554', Tor. 3572', Doug 3593',  
 Br lime 3720', Lans. 3749  
 DST 3848-68', opn 1 hr., rec. 100'  
 msw, 1120#  
 DST 3893-3908', opn 1 hr., rec. 270'  
 gas, 30' socm, 0#  
 Miss. 4163', Kh. 4188', Viola 4202',  
 Simp. sh 4244'  
 DST 4210-45', opn 1 hr., rec. 480' gas,  
~~55'~~ 55' so&gcm, 30' wm, 105#  
 Simp. sd 4266'  
 DST 4264-75', opn 1 hr., rec. 320'  
 sw, 1110#  
 Arb. 4350'  
 TD 4370'  
 D&A

**ABANDONED**

County Pratt State Kansas

Sec. 36 (Blk. 26) (Sur. Rge.) 13W Map No.

Operator McKnab Drlg.

Well No. 1 Farm Beck

Elev. 1924 Location NE NW SW


330 Ft. From N Line SW

990 Ft. From W Line Quarter

Ist. Report

Completion APR 20 1955

Remarks Iuka-Carmi Pool

Co. tools

Spudding Date 4-1-55

Drlg. Data D & A TD 4370

8" @ 455 Heeb. 3554 Tor. 3572

Doug. 3593 Br. line 3720 Lans. 3749

DST 3848-68 open 1 hr. Rec. 100' msw

1120# DST 3893-3908 open 1 hr.:

Rec. 270' gas 30' socm 0# Miss. 4163

Kh. 4188 Viola 4202 Simp. sh. 4244

DST 4210-45 open 1 hr. Rec. 480' gas

55' so & gcm 30' wm 105#

Simp. sd. 4266 DST 4264-75 open 1 hr.

Rec. 320' sw 1110# Arb. 4350 TD 4370

D & A

FABEN GILSTRAP

County Pratt State Kansas

Sec. 36 (Blk. Twp.) 26 (Sur. Rge.) 13W Map No.

Operator McKnab Drlg.

Well No. 1 Farm Beck

Elev. Location NE NW SW

FIRST REPORT					

330 Ft. From N Line SW

990 Ft. From W Line Quarter

Ist. Report APR 6 1955.

Completion

Remarks

Co. tools

Spudding Date 4-1-55

Drlg. Data Iuka-Garmi Pool

8" @ 455 drlg. 1200