


Section 36 Township 26 Range 13 W

Well No. # 1 Beck

Company Peters Riter & Christianson

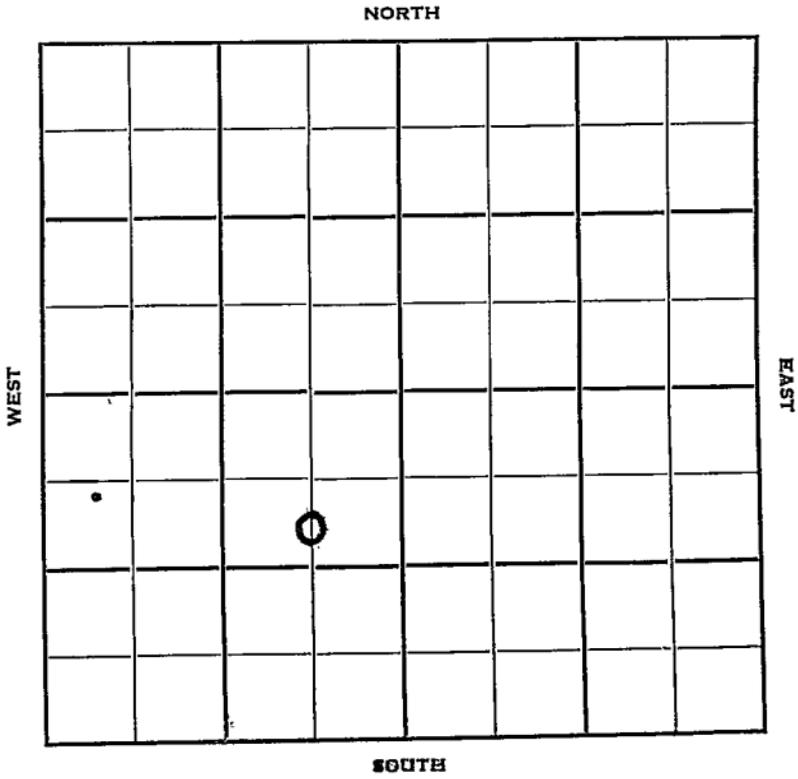

Sec. 36 Twp. 26 R. 13W

Well No. #1 Beck Farm

Peters Riter & Christianson
Company

Armer Contractor


990 Ft. from N. Line

Ft. from S. Line

660 Ft. from E. Line

Ft. from W. Line

C S L NE SW

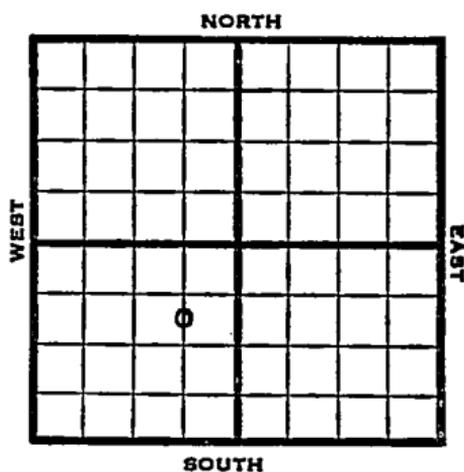

1952 Elev. 1923' REPORT

11/19 Spud 11-13-52
8" @ 489'
Drlg. 2770'

11/27 V. 4160
Drlg. 4220'

12/4 DST 4160-72, opn 1 hr., rec. 30'
mud
DST 4198-4240, opn 1 hr., rec.
35' mud,
Arb. 4347
TD 4366'

12/10 Spud 11-13-52
D&A
TD 4366
8" @ 489
Heeb 3550, Br lime 3721, Lans
3740
DST 3765-95, opn 1 hr., rec.
90' vsocm 420#
DST 3922-36, opn 1 hr., rec. 15'
mud
Viola 4160, Miss 4115, Kh 4137,
DST 4160-72, opn 1 hr., rec.
30' mud
DST 4198-4240, opn 1 hr., rec.
35' mud

OVER

#1 Beck

(Information Brought Forward)

1952

12/10 Arb. 4347, Simp 4234

DST 4253-94, opn 1½ hrs., rec.

420' wtr., 1280#

D&A

ABANDONED

County Pratt State Kansas

Sec. 36 (Blk. 26) (Sur. 13W) Map No.

Operator Peters Riter & Christianson

Well No. 1 Farm Beck

Elev. 1923 Location C S L NE SW

990 Ft. From N Line SW
660 Ft. From E Line Quarter

1st. Report

Completion DEC 10 1952

Remarks

Armer - Contr.

Spudding Date 11-13-52

Drig. Data D & A TD 4366

8" @ 489 Heeb. 3550 Br. lime 3721

Lans. 3740 DST 3765-95 open 1 hr.

Rec. 90' vsocm 420# DST 3922-36

open 1 hr. Rec. 15' mud Viola 4160

Miss. 4115 Kh. 4137 DST 4160-72

open 1 hr. Rec. 30' mud DST 4198-4240

open 1 hr. Rec. 35' mud Arb. 4347

Simp. 4234 DST 4253-94 open 1 1/2 hr.

Rec. 420' wtr. 1280#

D & A

