

KANSAS


Pratt

FORM 51 5M 1-42 PETROL

Section 36 Township 26 Range 13-W

Well No. #2 Harrell (Harrell)

Company Hollow Drilling

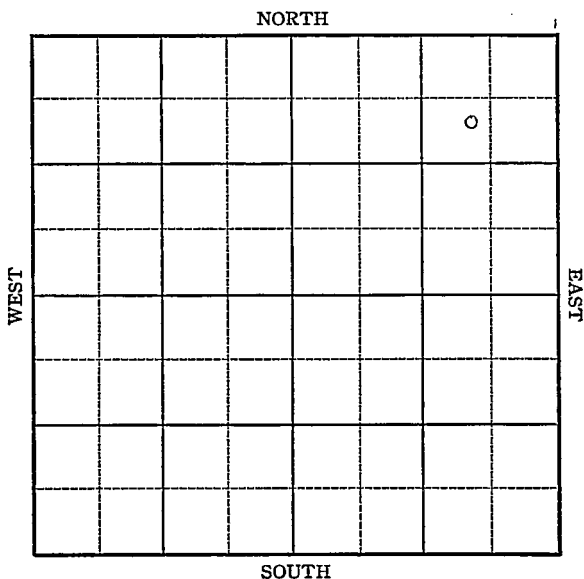

KANSAS

Pratt

Sec. 36 Twp. 26 R. 13

Well No. #2 Harrell Farm

Hollow Drilling Company

Iuka


990 Ft. from N. Line

 Ft. from S. Line

990 Ft. from E. Line

 Ft. from W. Line

Elev. 1927

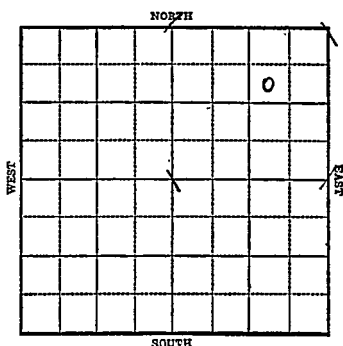

1943

R E P O R T

3/24	Material
3/31	Derrick
4/7	8" - 501
	Drlg. 600
4/14	Drlg. 2555'
4/21	Topeka 3165
	Lans. 3715
	Drlg. 3790
4/28	Miss. 4119
	Viola 4154
	Simp. 4190
	Arb. 4305-13 T.D.
	5" @ 4307'
	RUST No shows.
5/5	T.D. 4329'
	2400' oil.
5/12	Arb. 4305
	5" @ 4307'
	T.D. 4329'
	1000 gal. acid
	Depth Pot. 6810
	Max. 3000
	Gravity 40.9

COMPLETED

Pratt

KANSAS
Map No. 23 Sec. 36 Twp. 26 R. 13WWell No. 2 Harrell

Hollow Drilling

Company

FIRST REPORT

Contractor

SW NE NE

SECTION PLAT

			6

990 Ft. from N. Line

Ft. from S. Line

990 Ft. from E. Line

Ft. from W. Line

IUKA POOL

Location

Rig up

Drilling and Remarks:

Material

RECORD

Cased _____ in., _____ ft.

Sand _____

Gas _____

Oil _____

Total Depth _____

PRODUCTION

1st 24 hrs. Nat. _____

1st 24 hrs. after shot _____

Gas _____ Cu. Ft.

Dry Hole _____

Abandoned _____

Date

MAR 24 1943

19

S. J. LEWIS

Scout

Pratt

KANSAS

Map No. 83 Sec. 36 Twp. 26 R. 13WWell No. 2 HarrellHollow Drilling CompanyCOMPLETED Contractor

SW NE NE

SECTION FLAT

990 Ft. from N. Line Ft. from S. Line990 Ft. from E. Line Ft. from W. Line

			6

IUKA POOL

Location Rig up

Drilling and Remarks:

Core 4305
5" @ 4307
1000 Acid
Depth 6870
Max 3000
40 E Gr

RECORD

Cased in., ft.Sand Gas Oil Total Depth 4329

PRODUCTION

1st 24 hrs. Nat. 1st 24 hrs. after shot Gas Cu. Ft.Dry Hole Abandoned

Date

MAY 12 1943 19

S. I. LEWIS Scout