

# KANSAS


FORM 51 5M 1-42 PETROL

Pratt **O.W.P.B.**

Section 36 Township 26 Range 13~~W~~

Well No. #4 Harrel

Company Hollow Drilling *CRA*

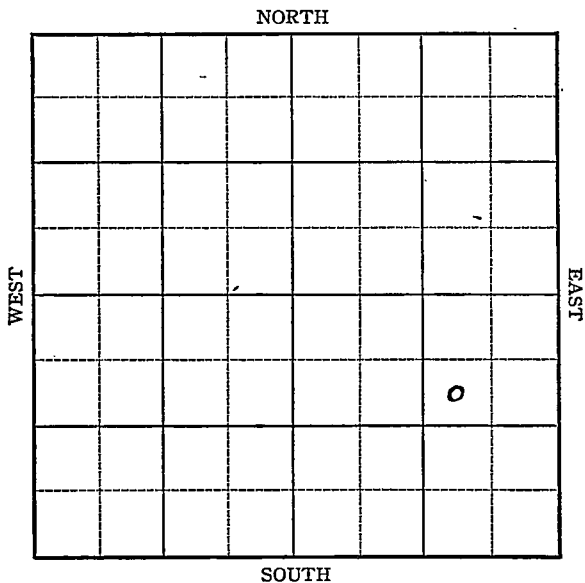

Sec. 36 Twp. 26 R. 13-W

Well No. #4 Harrel Farm

~~Hollow Drilling~~ CRA Company

Iuka


990 Ft. from N. Line

\_\_\_\_\_ Ft. from S. Line

<sup>3-1/2'</sup> 990 Ft. from E. Line

\_\_\_\_\_ Ft. from W. Line

Elev. 1930

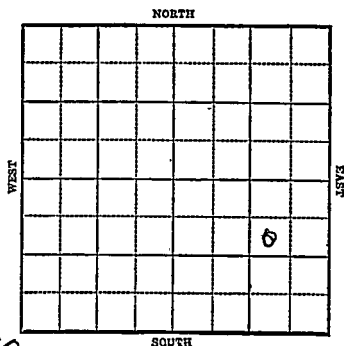

1943

R E P O R T

6/16	Rotary	
6/23	8 1/2 @ 466'	
	Drlg. 2604'	
6/30	Lans 3720	
	Drlg. 3844	
7/7	Arb 4320	
	T. D. 4325'	
	5" @ 4322 Rust	
7/15	T.D. 4334 1/2	
	2 1/2 bailers oil in 14 hrs.	
7/21	" " "	
7/28	Arb. 4320	
	5" @ 4322'	4320
	T.D. 4334 1/2'	1930
	500 acid	
	Echo Pot 1957	-2290
	Gravity 40.9	

**COMPLETED**

**O. W. P. B!**

1955

3/30 KC 3722' Viola 4169' Simp 4208'  
Arb. 4322'  
OTD 4325'  
5" @ 4324'  
CO to 4278' 48/ 4236-48 FU 3000'  
fluid S/ 77 bo 83 bw 8 hr. frac.  
F/ 13 bfph 3% BS&W tstg.

**OVER**

1955  
4/20

Oil Well - TD 4325'  
KC 3722', Viola 4169', Simp. 4208'  
Arb. 4322'  
OTD 4325'  
5" @ 4324'  
CO to 1278' 48/4236-48  
FU 3000' fluid  
S/77 bo 83 bw 8 hrs., frac.  
F/13 bfph 3% bs&w  
F/40.8 bo 4% wtr. 6 hrs.  
F/3.38 bo 4% bs&w 1 hr.  
F 84 bo 5 hrs.  
C<sub>omp.</sub> BHB F 2112 bopd

**COMPLETED**

Pratt

Map No. 83 Sec. 36 Twp. 26 R. 13W

Well No. 4 Harrel

Hollow Drilling Company

FIRST DEODOT Contractor

SW NE SE

990 Ft. from N. Line

\_\_\_\_\_ Ft. from S. Line

990 Ft. from E. Line

\_\_\_\_\_ Ft. from W. Line

## SECTION PLAT


IUKA POOL

Location \_\_\_\_\_

Rig up \_\_\_\_\_

Drilling and Remarks:

Rotary

## RECORD

Cased \_\_\_\_\_ in., \_\_\_\_\_ ft.

Sand \_\_\_\_\_

Gas \_\_\_\_\_

Oil \_\_\_\_\_

Total Depth \_\_\_\_\_

## .PRODUCTION

1st 24 hrs. Nat. \_\_\_\_\_

1st 24 hrs. after shot \_\_\_\_\_

Gas \_\_\_\_\_ Cu. Ft.

Dry Hole \_\_\_\_\_

Abandoned \_\_\_\_\_

Date

JUN 16 1943 19

S. J. LEWIS Scout

Pratt

KANSAS *83*  
Map No. *83* Sec. *36* Twp. *26* R. *13W*Well No. *4 Harrel*

Hollow Drilling Company

COMPLETED

Contractor

SW NE SE

SECTION PLAT

*990* Ft. from N. Line

\_\_\_\_\_ Ft. from S. Line

*990* Ft. from E. Line

\_\_\_\_\_ Ft. from W. Line

			<i>o</i>

TUKA POOL.

Location \_\_\_\_\_

Rig up \_\_\_\_\_

Drilling and Remarks:

*Co #4320**500 acid**500 acid**Echd Pat 1957**40-9-1/2*

RECORD

Cased \_\_\_\_\_ in., \_\_\_\_\_ ft.

Sand \_\_\_\_\_

Gas \_\_\_\_\_

Oil \_\_\_\_\_

Total Depth *4334 1/2*

PRODUCTION

1st 24 hrs. Nat. \_\_\_\_\_

1st 24 hrs. after shot \_\_\_\_\_

Gas \_\_\_\_\_ Cu. Ft.

Dry Hole \_\_\_\_\_

Abandoned \_\_\_\_\_

Date

JUL 28 1943

19

S. J. LEWIS

Scout

