


Section 4 Township 26 Range 13W

Well No. 1 Dodson

Company Skelly

Frisbie Pool
NORTH

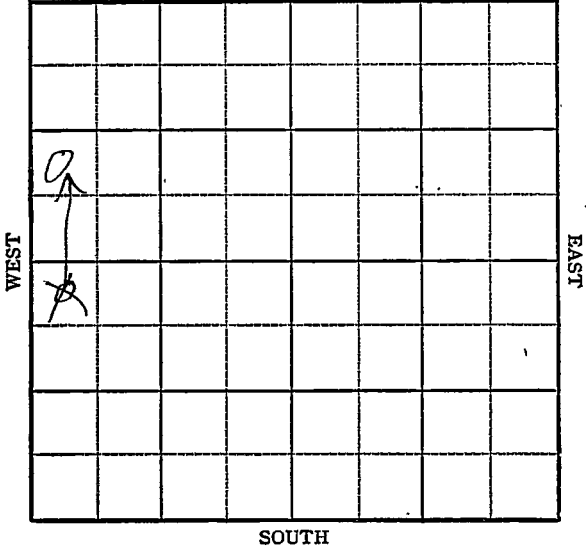

Sec. 4 Twp. 26 R. 13W ✓

Well No. 1 Dodson Farm

Skelly Company

Frisbie Pool


2970'
330 Ft. from N. Line

Ft. from S. Line

Ft. from E. Line

330 Ft. from W. Line

App. NW SW NW
NW NW SW

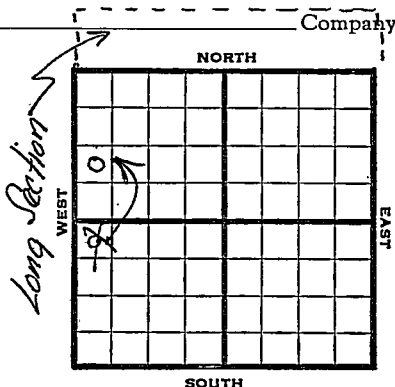

1948 Eli 1939' REPORT

8/25 8" @ 450'
Drlg. 2145'

9/1 Lansing 3713'
Drlg. 3820'

9/8 5" @ 4010'

9/14 "

9/21 71 shots 3908-18 - 1000 acid
Swb 85 bbls oil & 65 W ater

9/29 "

10/6 "

10/13 Swb 317 bbls oil & 6 W - 24hrs.

10/19 "

10/27 TD 4010'
Lans 3713'
5"@ 4010(
Perf 5000 acid
Pump 7070il / 103 W Pot
407 Gr.
Comp
COMPLETED

Map No. 83 Sec. 4 Twp. 26 R. 13WWell No. 1 DodsonSkelly Company

COMPLETE

Contractor

NW SW NW

E 11, 1939

SECTION PLAT

2970' S N L - long sec.

 Ft. from N. Line Ft. from S. Line Ft. from E. Line330 Ft. from W. Line

Pratt County

Location Rig up

Drilling and Remarks:

Lane 3713
*5" @ 4010**Perf.*
*5000 acres**Pump 707 oil + 103.4**Perf**403 gal*

RECORD

Cased in., ft.Sand Gas Oil Total Depth 4010

PRODUCTION

1st 24 hrs. Nat. 1st 24 hrs. after shot Gas Cu. Ft.Dry Hole Abandoned

Date

OCT 27 1948

19

S. J. LEWIS

Scout

Pratt County Kansas State

Map No. _____ Sec. 4 Twp. 26 R. 13W

Well No. 1 Dodson

Skelly Company

FIRST REPORT Contractor

NW NW SW


SECTION PLAT

330 Ft. from N. Line

_____ Ft. from S. Line

_____ Ft. from E. Line

330 Ft. from W. Line

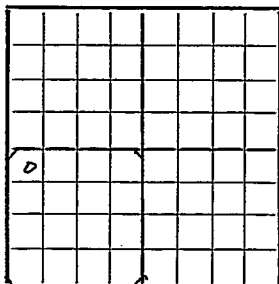

Frisbie Pool

Remarks:

8" @ 450', drlg. 2145

Date

AUG 25 1948

Scout

S. J. LEWIS

Pratt County Kansas State

Map No. 83 Sec. 4 Twp. 26 R. 13W

Well No. 1 Dodson

Skelly Company

CORRECTION

Contractor

Approx. NW SW NW

SECTION PLAT

 Ft. from N. Line

 Ft. from S. Line

 Ft. from E. Line

330 Ft. from W. Line

Frisbie Pool

Remarks:

This is a long section. This well is 2970' south of the North line of the section and 330' from the west line. Reported NW SW

Date
SEP 8 1948

Scout S. J. LEWIS