


Section 4 Township 26 Range 13W

Well No. #1 Fincham

Company K & E Drlg.

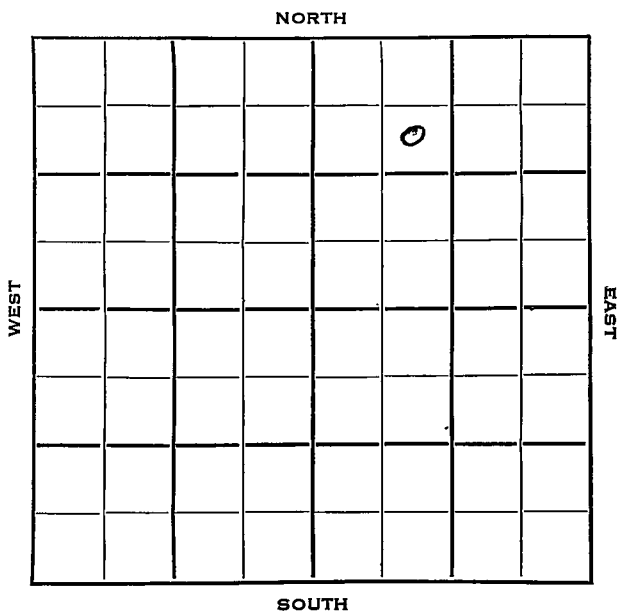

Sec. 4 Twp. 26 R. 13W

Well No. #1 Fincham Farm

K & E Drlg. Company


NE Frisbie Pool Contractor

\_\_\_\_\_ Ft. from N. Line

\_\_\_\_\_ Ft. from S. Line

\_\_\_\_\_ Ft. from E. Line

\_\_\_\_\_ Ft. from W. Line

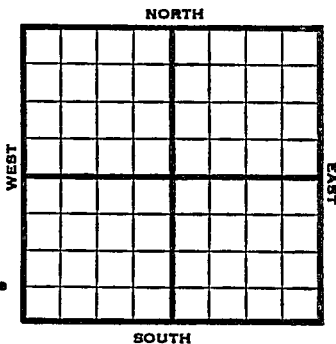

SE/c of Lot 2. (irreg. sec.)

1650' SL  
2500' NL  
1650' EL

1953

Elev. 1932'

REPORT

7/29

Location

8/5

"

8/19

"

8/26

"

9/2

"

9/9

"

9/16

8" @ 500'

Anhy 810'

Drlg 2664'

9/23

Heeb 3560, Br. L. 3732, Lans 3761

Drl g 4002'

9/30

Spud 9-8-53

D & A

TD 4375'

8" @ 500'

Anhy 810, Heeb 3560, Br. Lime 3732,

Lans 3761, B KC 4062, Miss 4189

DST 4179-4225' opn 1 hr, rec 180' gcm

330# Kh. 4260, Viola 4277, Simp 4354

TD 4375'

D & A

**ABANDONED**

County Pratt State Kansas

Sec. 4 (Blk. 26) (Sur. Rge.) 13W Map No.

Operator K & E Drlg.

Well No. 1 Farm Fincham

Elev. \_\_\_\_\_ Location SE/c of Lot 2 (irreg. sec.)


Ft. From \_\_\_\_\_ Line \_\_\_\_\_

Ft. From \_\_\_\_\_ Line \_\_\_\_\_ Quarter \_\_\_\_\_

Ist. Report JUL 29 1953

Completion \_\_\_\_\_

Remarks \_\_\_\_\_

Spudding Date \_\_\_\_\_

Drlg. Data NE Frisbie Pool

**Location**

County Pratt State Kansas

Sec. 4 (Blk.) 26 (Sur.) 13W Map No. (Twp.)

Operator K & E Drlg.

Well No. 1 Farm Fincham 1650' SL

Elev. 1932 Location SE/c Lot 2 2500' NL  
1650' ET


Ft. From Line  
Ft. From Line Quarter

Ist. Report

Completion SEP 30 1953

Remarks NE Frisbie Pool

Spudding Date 9-8-53

Drlg. Data D & A TD 4375

8" @ 500 Anhy 810 Heeb. 3560

Br. lime 3732 Lans. 3761 B KC 4062

Miss. 4189 DST 4179-4225 open 1 hr.

Rec. 180' gcm 330# Kh. 4260

Viola 4277 Simp. 4354 TD 4375

D & A