

KANSAS

Pratt

Section 4 Township 26 Range 13WWell No. 2 KippCompany Skelly

Frisbie

NORTH

0							

WEST

EAST

SOUTH

Pratt

KANSAS

26

13W

Sec. 4

Twp.

R.

Well No. #2 Kipp

Farm

Skelly

Company

Frisbie Pool


Ft. from N. Line

990' Ft. from S. Line

Ft. from E. Line

330' Ft. from W. Line

NW SW NW

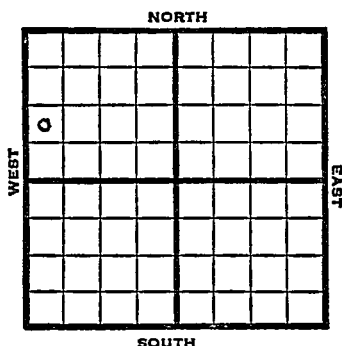

1949

Elev 1936'

REPORT

5/18

8" @ 440'

5/25

Dr1g. 2763'

6/1

Lansing 3723'

TD 4019'

5" @ 4019'

6/7

"

6/15

"

6/21

"

6/28

"

7/6

"

7/12

"

7.20

"

7/27

"

8/3

"

8/10

"

8/17

TD 4019'

Lansing 3723'

5" @ 4019'

Perf 3000 ac9d

Pump 43 Oil / 15W Pot

39° Gr.

Gomp

COMPLETED

Kansas

Map No. _____ Sec. 4 Twp. 26 R. 13WWell No. 2 Kipp

_____ Skelly _____ Company

_____ Contractor

NW SW NW

FIRST REPORT
SECTION PLAT

_____ Ft. from N. Line

990

_____ Ft. from S. Line

_____ Ft. from E. Line

_____ 330 Ft. from W. Line

o			

Pratt County

Location _____

Rig up _____

Drilling and Remarks:

8" @ 440

RECORD

Cased _____ in., _____ ft.

Sand _____

Gas _____

Oil _____

Total Depth _____

PRODUCTION

1st 24 hrs. Nat. _____

1st 24 hrs. after shot _____

Gas _____ Cu. Ft.

Dry Hole _____

Abandoned _____

Date

MAY 18 1949 19

S. J. LEWIS Scout

Kansas

Map No. K83 Sec. 4 Twp. 26 R. 13WWell No. 2 Kipp

Skelly

Company

COMPLETE

Contractor

NW SW NW

E 11786
SECTION PLAT

Ft. from N. Line

990 Ft. from S. Line

Ft. from E. Line

330 Ft. from W. Line

a			

Pratt County

Location

Rig up

Drilling and Remarks:

Lave 3723

5" C 4019

Prof.

2000000

Pump 43 oil + 15 W

Prof.

39 3/4

RECORD

Cased _____ in., _____ ft.

Sand _____

Gas _____

Oil _____

Total Depth 4019

PRODUCTION

1st 24 hrs. Nat. _____

1st 24 hrs. after shot _____

Gas _____ Cu. Ft.

Dry Hole _____

Abandoned _____

Date

AUG 17 1949

19

S. J. LEWIS

Scout