


Section 4 Township 26 Range 13W

Well No. 3 - J. B. Chase (Chance)

Company Skelly Oil

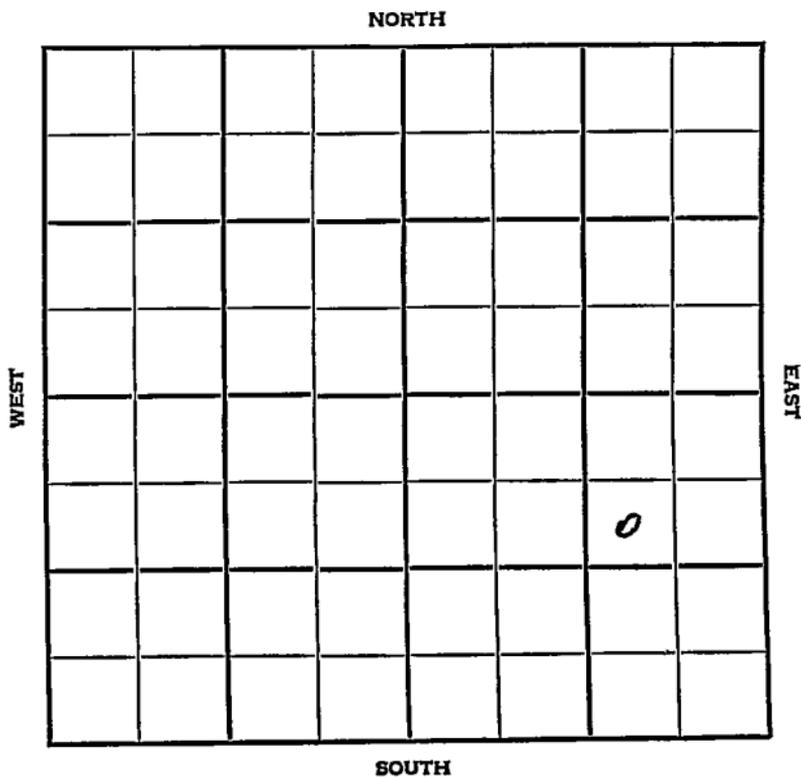

(Information Brought Forward)

1954

7/21

78/4190-4208', 250A "

S/6 bw 2 hrs.

PB 4143'

54/4103-12

Sd-oil-frac 24/4126-30 .

Sd-oil -frac dry

PB 4098

72/4285-97, 500A

S/4 bo 12 baw 12 hrs.

sd-oil-frac dry

EB 3858 67/3810-22, 29 go 49 gw 5 hrs

500A S/85 bw 24 hrs.

D&A

ABANDONED

Drilg. Data

sd-oil-frac dry PB/4098 72/ 4285-97

500 A S/4 bo 12 baw 12 hr.

sd-oil-frac dry PB 3858 67/ 3810-22

29 go 49 gw 5 hr. - 500 A S/ 85 bw 24 h

D & A
 and Wall Map
 and Small Map
 out Cards

JUL 27 1954