

Sec. 4 Twp. 26 R. 13W

Well No. #1 R. J. Kipp Farm


Skelly Company
Wildcat

2500 Ft. from N. Line

4990
330 Ft. from S. Line

_____ Ft. from E. Line

330 Ft. from W. Line

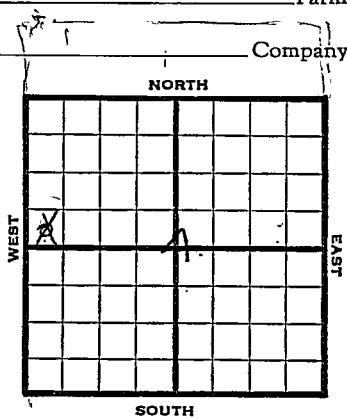

SW/4 Lot 4
~~SW NW~~

Elev. 1934' REPORT

1948	
4/28	Location
5/5	8" @ 420' Drlg. 2500'
5/12	Lansing 3702' Drlg. 3940'
5/19	Miss. 4028' Viola 4105' Simpson 4228' Arbuckle 4270' Drlg. 4320' 125 W
5/26	TD4370' 5" @ 3950'
6/1	88 shots 3889-3902' Swabb 139 bbls. oil / 31 W in 12 hrs.
6/9	"
6/16	"
6/23	"

OVER

1948

6/30 Lans. 3702'
Arbuckle 4270'
5" @ 3950'
Perf Lans.
2000 Acid
Pump 720 oil & 45 W Pot.
Gr. 39°
TD 4370'

COMPLETED

Map No. _____ Sec. 4 Twp. 26 R. 13W

Well No. 1 R. J. Kipp

Skelly Company

FIRST REPORT Contractor

SW NW


SECTION PLAT

_____ Ft. from N. Line

330 Ft. from S. Line

_____ Ft. from E. Line

330 Ft. from W. Line

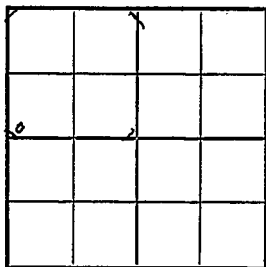

pratt County

Location X

Rig up _____

Drilling and Remarks:

RECORD

Cased _____ in., _____ ft.

Sand _____

Gas _____

Oil _____

Total Depth _____

PRODUCTION

1st 24 hrs. Nat. _____

1st 24 hrs. after shot _____

Gas _____ Cu. Ft.

Dry Hole _____

Abandoned _____

Date

APR 28 1948

19

S. J. LEWIS

Scout

Map No. 82 Sec. 4 Twp. 26 R. 13W

Well No. 1 R. J. Kipp

Skelly Company

CORRECTION Contractor

SW/C Lot 4

2500 Ft. from N. Line

4290 Ft. from S. Line

 Ft. from E. Line

330 Ft. from W. Line

SECTION PLAT

Pratt County

Location

Rig up

Drilling and Remarks:

A long section
Reported SW NW

RECORD

Cased in., ft.

Sand

Gas

Oil

Total Depth

PRODUCTION

1st 24 hrs. Nat.

1st 24 hrs. after shot

Gas Cu. Ft.

Dry Hole

Abandoned

Date

MAY 1 2 1948

19

S. J. LEWIS

Scout

Map No. 83 Sec. 4 Twp. 26 R. 13W

Well No. 1 R. J. Kipp

Skelly Company

COMPLETE

Contractor

SW/C Lot 4

E. 1934

SECTION PLAT

2500 Ft. from N. Line

4290 Ft. from S. Line

 Ft. from E. Line

330 Ft. from W. Line

Pratt County

Location

Rig up

Drilling and Remarks:

Lease 8702

Ac 4270

5" C 3750

Perf. 1/2 in. 20000

Pump 220 oil 44570

P. 89 2/2

RECORD

Cased in., ft.

Sand

Gas

Oil

Total Depth 4270

PRODUCTION

1st 24 hrs. Nat.

1st 24 hrs. after shot

Gas Cu. Ft.

Dry Hole

Abandoned

Date

JUN 30 1948

19

S. J. LEWIS

Scout