


Section 4 Township 26 Range 13W

Well No. #1 Chance

Company Skelly Oil Company

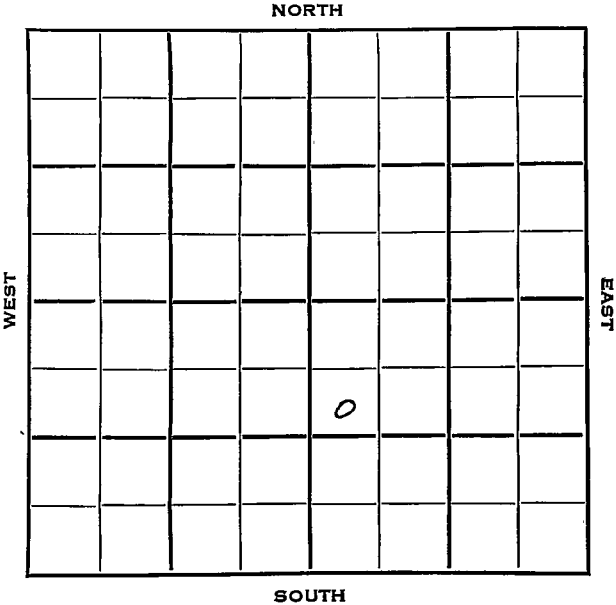

Pratt

Sec. 4 Twp. 26 R. 13WWell No. #1 Chance FarmSkelly Oil Company Company

Contractor


990 Ft. from N. Line

Ft. from S. Line

Ft. from E. Line

330 Ft. from W. Line

SW NW SE

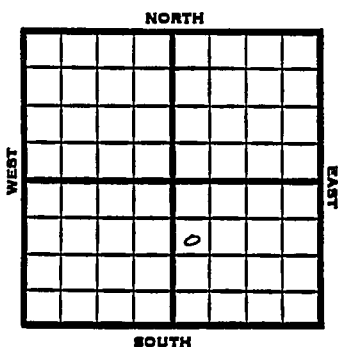

1953 Elev. 1940' REPORT

3/11 Location

3/19 8" @ 460'

3/26 Drlg. 2690'

4/2 Drlg.

4/9 Drlg.

4/16 NR

4/23 "

4/30 "

5/7 P/206 BOPD

5/20 Spud 3-14-53

Oil Well

TD 4351'

8" @ 460'

Heeb 3536, Br. Lime 3699, Lans 3726.

DST 3802-26 opn 2 hr, rec 450' gas & mco 30' sw 1078#

DST 3861-74 opn 2 hr, rec 60' o & gcm 180' g & mco 970#

DST 3894-3924 opn 2 hr, rec 120' o & gcm 217#

DST 3930-61 opn 2 hr, rec 170' ho & gcm 175' gco, 5' sw, 1103#

DST 3974-4003 opn 2 hr, rec 150' o & gcm 115' g & mco 5' sw. 975#

Miss 4132,


OVER

1953

Information brought forward

5/20 DST 4131-56 opn 2 hr, rec 35' mud
210# Viola 4160, Simp 4271, Simp sd
4274,
DST 4263-91 opn 1 hr, gas in 8 min,
rec 3130' oil Arb 4330
TD 4343
5" @ 4343'
DD 4349 1 bw & SSO DD 4351 PB 4302
96/ 4274-90 S/ 185 bo 7 hr. D-hydro
F/ 80 bo 5 hr. F/ 267 bo 19 hr.
P/ 206 bopd
Comp. 1772 bopd.

COMPLETED

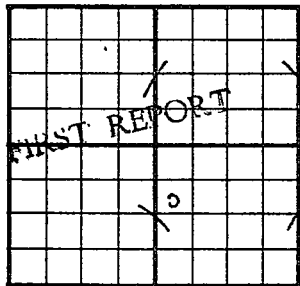County Pratt State KansasSec. 4 (Blk.) 26 (Sur.) 13W Map No.Operator Skelly OilWell No. 1 Farm ChanceElev. Location SW NW SE990 ft. From N Line SE330 ft. From W Line Quarter1st. Report MAR -1 1 1953

Completion

Remarks


Spudding Date

Drlg. Data

Location

J. G. McGEHEE

County Pratt State Kansas
 Sec. 4 (Blk.) 26 (Sur. Rge.) 13W Map No. _____
 Operator Skelly Oil
 Well No. 1 Farm Chance
 Elev. 1940 Location SW NW SE

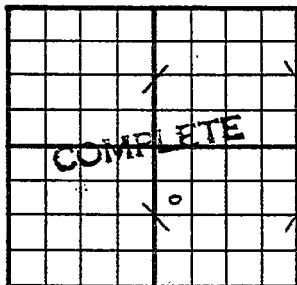

990 Ft. From N Line SE
330 Ft. From W Line Quarter
 1st. Report _____
 Completion MAY 20 1953
 Remarks E. Frisbie Pool
 Spudding Date 3-14-53

Drlg. Data Oil well TD 4351
8" @ 460 Heeb. 3536 Br. lime 3699
Lans. 3726 DST 3802-26 open 2 hr.
Rec. 450' gas & mco 30' sw 1078#
DST 3861-74 open 2 hr. Rec. 60' o & gcm
180' g & mco 970# DST 3894-3924
open 2 hr. Rec. 120' o. & gcm 217#
DST 3930-61 open 2 hr. Rec. 170' ho &
gcm 175' gco 5' sw 1103# DST 3974-
4003 open 2 hr. Rec. 150' o & gcm
115' g & mco 5' sw 975# Miss. 4132
DST 4131-56 open 2 hr. Rec. 35' mud
210# Viola 4160 Simp. 4271
Simp. sd. 4274 DST 4263-91 open 1 hr.
gas in 8 min. Rec. 3130' oil

J. G. McGEHEE

Drlg. Data

Arb. 4339 TD 4343 5" @ 4345 DD 4349

1 bw & SSO DD 4351 dew PB 4302 96/ 4274-90

S/ 185 bo 7 hr. D-hvd 211 F/ 80 bo 5 hr.

F/ 267 bo 10 hr. Comp/ 206 bovd

Comp. 1772/bovd

MAY 26 1953

Scout Card

Small Mass

Land







