DX 78-1


Pratt

KANSAS

Section 6 Township 26 S Range 13 W

Well No. #1 Henderson

Company SDX

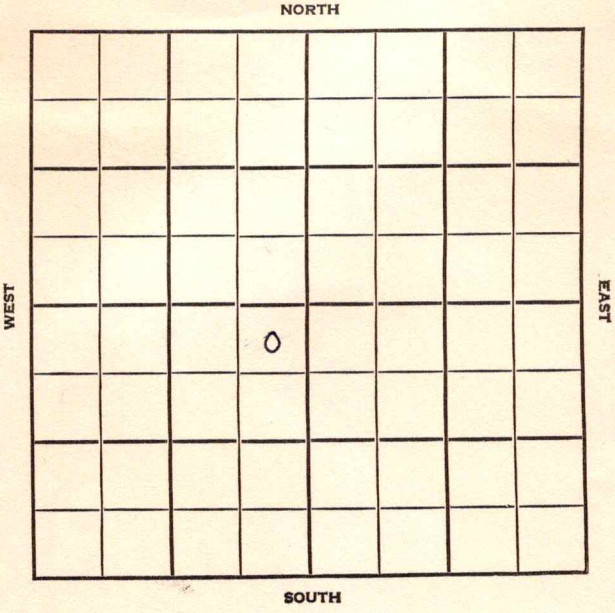

HOT FILE

SEC.	TWP.	R.	Pratt	KANSAS
6	26 S	13 W		

WELL NO.

1 Henderson FARM

COMPANY

Sunray Mid-Continent (DEVELOPMENT)

CONTRACTOR

Stickle Drlg. Co.
Frisbie

330 Ft. from N. Line


~~330~~ Ft. from S. Line

330 Ft. from E. Line

Ft. from W. Line

of SW/4

~~SE SE SW~~ → NE NE SW

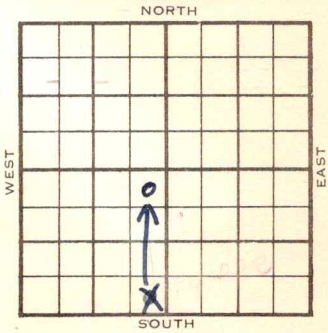

1955	ELEVATION 1960' REPORT
	Projected Lansing-Kansas City @ 4100'
9/27	Spud 9-26-55 Drlg. 385' (DR #189)
9/28	Comm. 9-4-55 Drlg. 385' (F.R. Tkt)
9/28	TD 585'. WOC - 8-5/8" @ 583'
9/29	Drlg. 775'
9/30	Drlg. 2065'
10/3	Drlg. 3410'
10/4	Drlg. 3685'
10/5	Drlg. 3885' DST 3870-85, 1 hr, good blow thruout. (corrected location - 330'FSL of N/2 N/2 SW/4 & 330' FEL of SW/4) (DR#195)
10/6	Drlg. 3967'. DST #1, 3870-85', 1 hr, good blow, rec 180' salt wtr. FP 100#. BHP 1220#- DST #12, 3922-37', 1 hr, rec 50' slightly oil & gas cut mud. FP 30# BHP 550#.
10/7	TD 4110'. Running logs.
10/10	TD 4120'. WOC 5½" @ 4120'
10/11	TD 4120'. " "
10/12	TD 4120'. MICT
10/13	TD 4120'. Prep to perf., Heeb. 3596, Tor. 3613, B. Gread 3638, Br.Lime 3762 Land 3785, BKC 4088,

DX-78

OVER

1955

10/14 TD 4120'. Testing. Perf 4059-65'

10/17 TD 4120'. Testing. Perf 3931-35 and acidized.

10/18 TD 4120'. Perf 3802-10' Swabbed 6 hrs @ 1/2 BW/Day rate, slight show of oil.

10/19 TD 4120'. Temporarily Abandoned 10-17-55 (DDR #205)

10/19 Comm 9-26-55
8 5/8" @ 583/600

H	3595	3596
Tr		3613
B. Cread		3638
B1	3761	3762
L	3785	3785
BKC	4096	4088

TD 4120
DST 3870-85 open 1 hr Rec 180' sw 1220/30" DST 3922-37 open 1 hr rec 50' so & gcm 550/30" TD 4120
5½" @ 4119 CO 36/4059-65 dry 750 A dry SP 4060 16/3931-35 1 go 1 hr 1000 A 1 boph 2000 A 1 bwph SP 3860 32/3802-10 1 bwph 6 hr
D & A

COMPLETED

FORM 513 REV. SUNRAY

County Pratt Elev.

Sec. 6 Twp. 26S Rge. 13W

Company Sunray Mid-Continent

Farm Name Henderson No. 1

TOPS	DEPTH	LOG	DATUM
Anh.			
T.P.			
H.			
Tr.			
Dg.			
B.L.			
L.			
K.C.			
B.K.C.			
Ce.			
C.			
M.			
M.			
K.			
Mz.			
Mg.			
V.			
S.			
S.			
A			
R.			
P€.			
G.			
T.D.			

Loc. in Sec. NE NE SW

Geol.

Contr. Stickle

Pool Frisbie

FIRST REPORT

Date Comm. 9-4-55

SEP 28 1955

D 385

Co. Lse. No. Sec. T. R.

FORM 513 REV. SUNRAY

County Pratt Elev. 1960 KB 1957 DF

Sec. 6 Twp. 26 Rge. 13W

Company Sunray Mid-Continent

Farm Name Henderson No. 1

TOPS	DEPTH	LOG	DATUM
Anh.			
Tp.			
H.	3595	3596	1639
Tr.		3613	1656
Dg. B. Dread		3638	1681
Bl.	3761	3762	1805
L.	3785	3785	1828
K.C.			
B.K.C.	4096	4088	2131
Ce.			
C.			
M.			
M.			
K.			
Mz.			
Mo.			
V.			
S.			
S.			
A			
R.			
P€.			
G.			
T.D.	4120		

Loc. in Sec. NE NE SW

Geol.

Contr. Stickle

Pool Frisbie

ABANDONED

OCT 19 1955

Date Comm. 9-26-55

8 5/8" @ 583/600 DST 3870-85

open 1 hr. rec. 180' sw 1220/30"

DST 3922-37 open 1 hr. rec. 50' so

& gcm 550/30" TD 4120 5½" @ 4119

CO 36/ 4059-65 dry 750 A dry

SP 4060 16/ 3931-35 1 go 1 hr.

1000 A 1 boph 2000 A 1 bwph

SP 3860 32/ 3802-10 1 bwph 6 hr.

D & A

Co. Lse. No. Sec. T. R.