


Section 6 Township 26 Range 13W
Well No. 3^F red Smith
Company Texas Co.

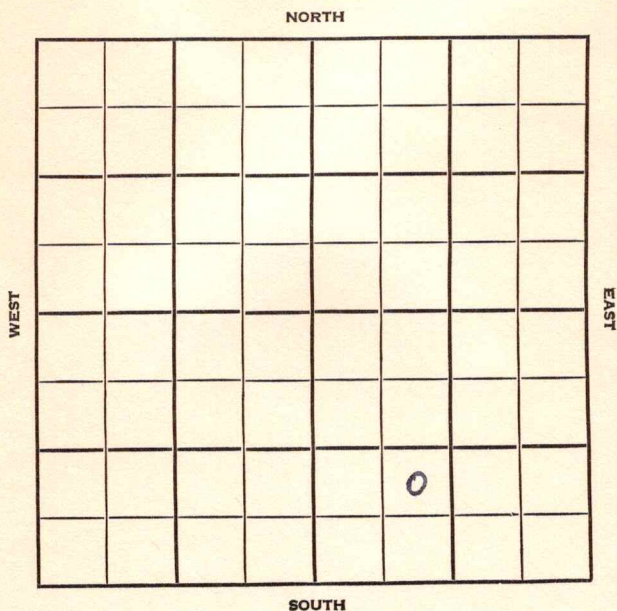

SEC.	TWP.	R.
6	26	13W

WELL NO.

3 Fred Smith

FARM

COMPANY

Texas Co.

CONTRACTOR

Noble Drlg.
Frisbie Pool

Ft. from N. Line


990

Ft. from S. Line

Ft. from E. Line

990

Ft. from W. Line

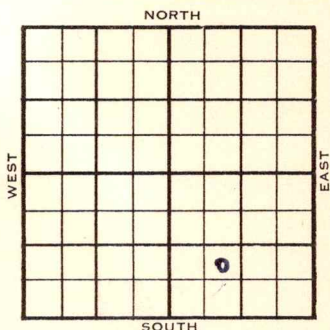

NE SW SE

	ELEVATION	REPORT
1955	1962	

2/2

MIR

3/16

Spud 2-8-55, Oil Well, TD 4050
10" @ 516, Lans 3769,

TD 4050

7" @ 4049, CO to 4014,

24/3916-22, 2 1/2 BOPH 1 1/2 hr

2000 A P/101 BO 12 hr

LOG TOPS: Anhy 864, Top 3235,

Heeb 3584, Br Lime 3743, Lans
3767,

Comp. 184 BOPD

COMPLETED

FABEN GILSTRAP

County Pratt State Kansas
 Sec. 6 (Blk. 26) (Sur. 13W) (Twp.) Map No.
 Operator Texas Company
 Well No. 3 Farm Fred Smith
 Elev. 1962 Location NE SW SE



990 Ft. From S Line SE
990 Ft. From W Line Quarter
 1st. Report
 Completion MAR 16 1955
 Remarks Frisbie Pool
Noble Drlg. - Contr.
 Spudding Date 2-8-55

Drlg. Data Oil well TD 4050
10" @ 516 Lens. 3769 TD 4050
7" @ 4049 CO to 4014 24/ 3916-22
2 $\frac{1}{2}$ boph 1 $\frac{1}{2}$ hr. 2000 A P/ 101 bo
12 hr. LOG DOPS:
Anhy 864 Top. 3235 Heeb. 3584
Br. lime 3743 Lens. 3767
Comp. 184 bopd

FABEN GILSTR