KANSAS


FORM 51 5M 1-42 PETROL

Pratt

Section 5 Township 26 Range 13-W

Well No. #1 Frisbie

Company Texas

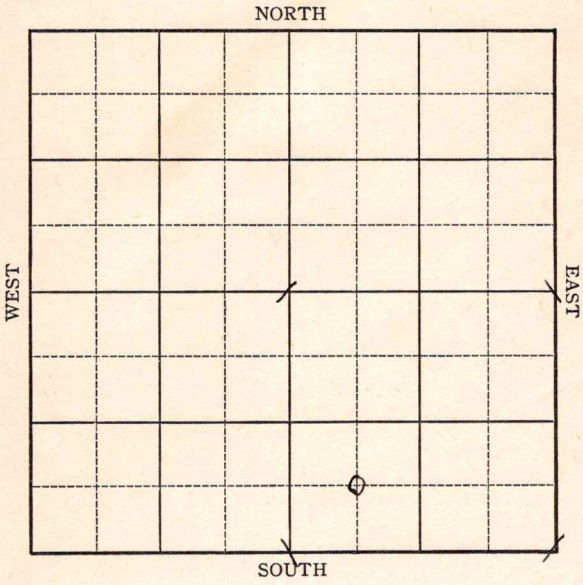

FORM 252-A
5M 9-42 GASS

KANSAS

Pratt

Sec. 5 Twp. 26 R. 13-W

Well No. #1 Frisbie Farm

Texas Company




____ Ft. from N. Line

660 Ft. from S. Line

1980 Ft. from E. Line

____ Ft. from W. Line

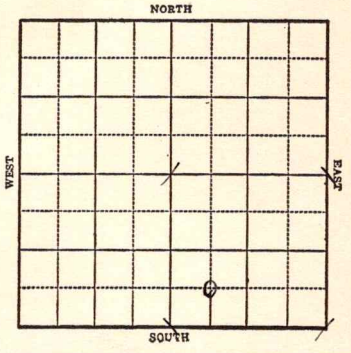


Elev. 1953

| 1943 | REPORT |
|---|---|
| 5/19 | Derrick |
| 5/26 | Surface hole. |
| 6/2 | 9" @ 855' |
| | Drlg. 2845' |
| 6/9 | Drlg. 3104' |
| 6/16 | Drlg. 3404' |
| 6/23 | Lans 3746 |
| | T.D. 3993' |
| | SO |
| | 7" @ 3993' RUST |
| 6/30 | 8 shots 3938-45 SO |
| | 5 shots 3934-38 SO |
| | 11 shots 3930-34½ SO |
| | 11 shots 3934-38½ SO |
| | Cleaning out. |
| 7/7 | 4500 gal acid |
| | Flow 194 oil in 5 hrs. |
| 7/14 | " " |
| 7/21 | Flow 472 oil in 24 hrs. |
| 7/28 | Lans 3746 |
| | 7" @ 3993 |
| | T.D. 3993' |
| | Perf. Lans. |
| | 4500 acid |
| | Pump & flow 474 Bbl Pot. |
| | Gravity 32.7 |

COMPLETED

Form 26 200 Bks 5-42 Petrol

KANSAS 8/3

Pratt

Map No. 8/3 Sec. 5 Twp. 26 R. 13W


Well No. 1 Frisbie

Texas Company

COMPLETED Contractor

C SW SE

SECTION PLAT

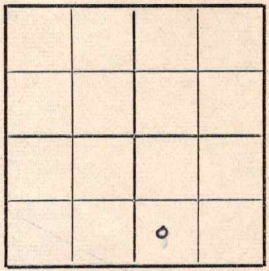

____ Ft. from N. Line

660 Ft. from S. Line

1980 Ft. from E. Line

____ Ft. from W. Line

FRISBIE POOL

Location

Rig up

Drilling and Remarks:

Lans 3746
? "C" 3993
Perf Lans.
4500 Rec C
Pump & Flow 474 BO
32.2 Gr

RECORD

Cased ____ in., ____ ft.

Sand

Gas

Oil

Total Depth 3993

PRODUCTION

1st 24 hrs. Nat.

1st 24 hrs. after shot

Gas Cu. Ft.

Dry Hole

Abandoned

Date

JUL 28 1943 19

S. J. LEWIS Scout

Form 26 200 Bks 5-42 Petrol

KANSAS

Pratt

Map No. 83 Sec. 5 Twp. 26 R. 13W


Well No. 1 Frisbie

Texas Company

FIRST REPORT Contractor

C SW SE

SECTION PLAT

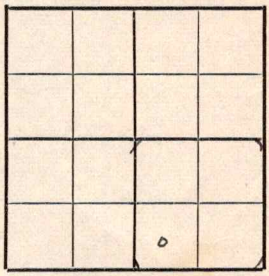

____ Ft. from N. Line

660 Ft. from S. Line

1980 Ft. from E. Line

____ Ft. from W. Line

FRISBIE POOL

Location

Rig up

Drilling and Remarks:

Derrick

RECORD

Cased ____ in., ____ ft.

Sand

Gas

Oil

Total Depth

PRODUCTION

1st 24 hrs. Nat.

1st 24 hrs. after shot

Gas ____ Cu. Ft.

Dry Hole

Abandoned

Date

MAY 1 9 1943 19

S. J. LEWIS Scout