KANSAS


Pratt

FORM 51 5M PETROL

Section 5 Township 26 Range 13-W

Well No. #1 F. Smith

Company Stanolind

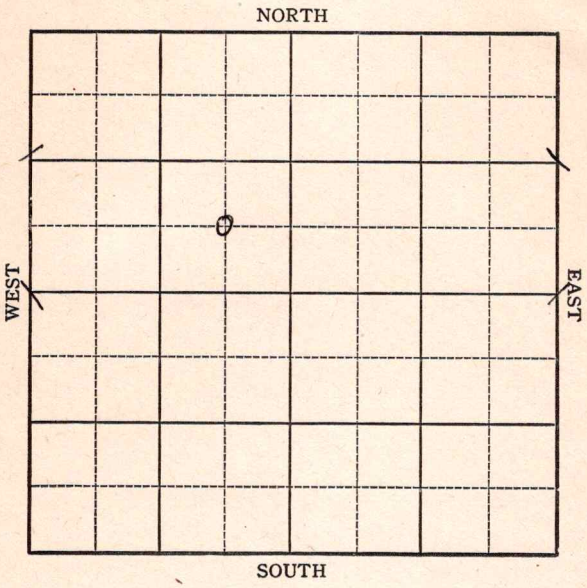


FORM 252-A 5M 10-38 KANSAS Pratt

Sec. 5 Twp. 26S R. 13-W

Well No. #1 F. Smith Farm

Stanolind Company

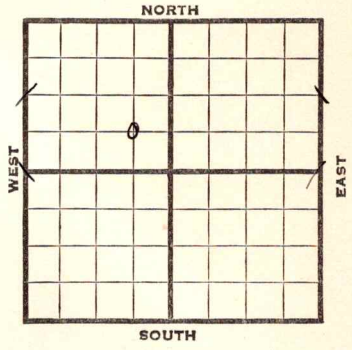

____ Ft. from N. Line

660 Ft. from S. Line

660 Ft. from E. Line

____ Ft. from W. Line

1943	Elev. 1944 REPORT
9/1	Location
9/8	13" @ 276' Drlg. 2180'
9/15	Drlg. 3728'
9/22	Lans 3775 No shows
	T. D. 4043
	ABANDONED

Form 26 200 Bks 5-42 Petrol

Pratt

KANSAS

Map No. 83 Sec. 5 Twp. 26 R. 13W


Well No. 1 F. Smith

Stanolind Company

FIRST REPORT Contractor

C SE NW

SECTION PLAT

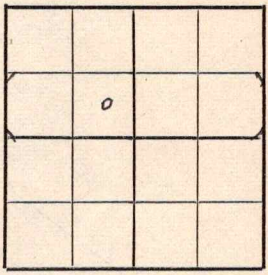

Ft. from N. Line

660 Ft. from S. Line

660 Ft. from E. Line

Ft. from W. Line

Frisbie Pool

Location X

Rig up

Drilling and Remarks:

RECORD

Cased in., ft.

Sand

Gas

Oil

Total Depth

PRODUCTION

1st 24 hrs. Nat.

1st 24 hrs. after shot

Gas Cu. Ft.

Dry Hole

Abandoned

Date

SEP 1 1943 19

S. J. LEWIS Scout

Form 26 200 Bks 5-42 Petrol Pratt

KANSAS

Map No. 83 Sec. 5 Twp. 26 R. 13W


Well No. 1 F. Smith

Stanolind Company

ABANDONED Contractor

C SE NW

SECTION PLAT

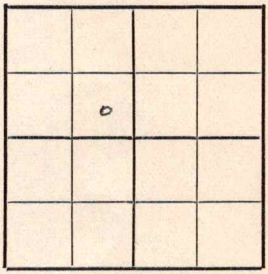

____ Ft. from N. Line

660 Ft. from S. Line

660 Ft. from E. Line

____ Ft. from W. Line

Frisbie Pool

Location

Rig up

Drilling and Remarks:

Lans 3775

Noelwods

RECORD

Cased ____ in., ____ ft.

Sand

Gas

Oil

Total Depth 4043

PRODUCTION

1st 24 hrs. Nat.

1st 24 hrs. after shot

Gas ____ Cu. Ft.

Dry Hole

Abandoned

Date

SEP 2 2 1943 19 S. J. LEWIS Scout