


Section 6 Township 26 Range 13 W

Well No. #1 F. Smith

Company Texas Co.

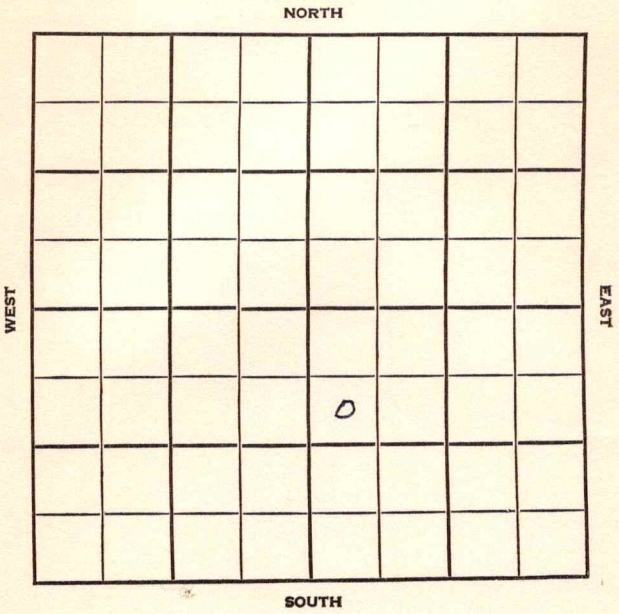


SEC. **6** TWP. **26** R. **13W**

WELL NO. \_\_\_\_\_  
 #4 F. Smith FARM  
 COMPANY

Texas Company  
 CONTRACTOR

Noble  
 Frisbie

\_\_\_\_\_ Ft. from N. Line  
 \_\_\_\_\_ Ft. from S. Line  
 \_\_\_\_\_ Ft. from E. Line  
 \_\_\_\_\_ Ft. from W. Line

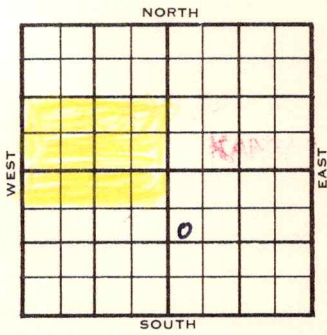

SW NW SE  
**SDX OFFSET**

	ELEVATION	REPORT
1955	1963' DF	
8/17	MIR	
8-25	Spud 8-17-55, 10 3/4" @ 600/450, drlg. 3345	
9-2	Heeb. 3578, Tor. 3586, Br. line 3726, Lans. 3769	
	DST 3833-61, open 1 hr., rec. 3400' gas, 150' hocg, 1056/30", 7" @ 4084/225, WOC	
9-8	PB 4061., 20/ 3902-07, gas to surface in 12 min., S/ 13.44 bo 3 hr., 2000 A, no test	
9/14	Comm. 8-17-55 10-3/4" @ 600 w/450 DST 3833-61 open 1 hr rec 3400' gas, 150' OCGM, 1056# BHP 30" 7" @ 4084 PB 4061 20/3902-07 Gas to surf. 12". Swab 13.44 BO, no water 3 hrs. 2000 A. Flowed 217.93 BO, no water 8 hrs. Est pot. Flo 654 BOPD, no water. Tops: H. 3578', Tr. 3586', BL 3726', L. 3769' Log: BL 3726', L. 3761'	

**COMPLETED**

County Pratt Elev. \_\_\_\_\_  
 Sec. 6 Twp. 26 Rge. 13W  
 Company Texas Company  
 Farm Name F. Smith No. 4

TOPS	DEPTH	LOG	DATUM
Anh.			
T.P.			
H.			
Tr.			
Dg.			
B.L.			
L.			
K.C.			
B.K.C.			
Ce.			
C.			
M.			
M.			
K.			
Mz.			
Me.			
V.			
S.			
S.			
A.			
R.			
PE.			
G.			
TD.			

Loc. in Sec. SW NW SE  
 Geol. \_\_\_\_\_  
 Contr. \_\_\_\_\_  
Noble  
 Pool \_\_\_\_\_  
Frisbie

AUG 17 55	
FIRST REPORT	
	0
offset	

Date Comm. M I R

*226*

Co.  
Lse.  
No.  
Sec.  
T.  
R.

County Pratt Elev. 1963 DF  
 Sec. 6 Twp. 26S Rge. 13W  
 Company Texas Company  
 Farm Name F. Smith No. 4

TOPS	DEPTH	LOG	DATUM
Anh.			
Tp.			
H.	3578		1615
Tr.	3586		1623
Dg.			
B.L.	3726	3726	1763
L.	3769	3761	1798
K.C.			
B.K.C.			
Ce.			
C.			
M.			
M.			
K.			
Mz.			
Ma.			
V.			
S.			
S.			
A			
R.			
Pe.			
G.			
T.D.	4085		

Loc. in Sec. SW NW SE  
 Geol. \_\_\_\_\_  
 Contr. \_\_\_\_\_  
 Pool Noble  
Frisbie  
 COMPLETE  
 0

Date Comm. 8-17-55 SEP 14 1955

10-3/4" 600 w/450; DST 3833-61 op 1 hr.  
 rec. 3400' gas, 150' hocgm, 1056# BHP 30";  
 7" 4084; PB 4061; 20/3902-07; gas to surf  
 12"; swb 13.44 bo no wtr. 3 hrs.; 2000 A;  
 flowed 217.93 bo no wtr. 8 hrs;  
 est. pot flo 654 bopd no wtr.