

Pratt **KANSAS**

SECTION 6 TOWNSHIP 26 RANGE 13 W

WELL NO. #6 Fred Smith

COMPANY Texas Company

NORTH

						0	

WEST

EAST

SOUTH

Pratt

KANSAS

SEC. 6-	TWP. 26	R. 13W
------------	------------	-----------

WELL NO.

#6 Fred Smith

FARM

COMPANY

Texas Company

CONTRACTOR

Noble

Frisbie


_____ Ft. from N. Line

_____ Ft. from S. Line

_____ Ft. from E. Line

_____ Ft. from W. Line

SW SE NE

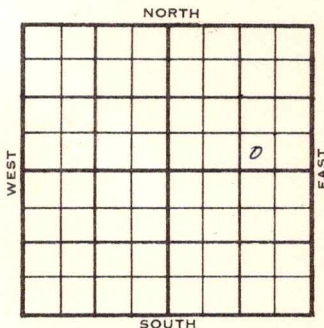

1955	ELEVATION 1952'	REPORT
------	--------------------	--------

11-23 Comm. 11-19-55
 10" @ 596/500
 Drlg. 2120

12-14 DST 3901-16 op 1½ hr. rec. 1625' GIP
 75' ocm, 270' sw, 820/30"
 7" @ 4094/225
 CO to 4059, 16/ 3910-14
 B/ 67 gw 6 hrs. frac, 500 A
 S/ 11 bo, 33 bw 4 hrs.
 16/ 4016-20, 2½ bo, 48 bw 13 hrs.
 D & A
 H. 3571
 BL. 3734
 L. 3759
 TD 4094'

ABANDONED

County Pratt Elev. _____
 Sec. 6 Twp. 26 Rge. 13W
 Company Texas Company
 Farm Name Fred Smith No. 6

TOPS	DEPTH	LOG	DATUM	Loc. in Sec.
Anh.				SW SE NE
TP.				
H.				
Tr.				
Dg.				
Bl.				
L.				Geol.
K.C.				Contr.
B.K.C.				<u>Noble</u>
Ce.				Pool
C.				<u>Frisbie</u>
M.				
M.				
K.				
Mz.				
Mo.				
V.				
S.				
S.				
A.				
R.				
PE.				
G.				
T.D.				

FIRST REPORT


NOV 23 1955

Date Comm. 11-19-55
10" @ 596/500 drlg. 2120

26

County Pratt Elev. 1952
 Sec. 6 Twp. 26 Rge. 13W
 Company Texas Company
 Farm Name Fred Smith No. 6

TOPS	DEPTH	LOG	DATUM	Loc. in Sec.
Anh.				SW SE NE
Tr.				
H.	<u>3.571</u>		<u>1619</u>	
Dg.				
B.L.	<u>37.34</u>		<u>1782</u>	
L.	<u>37.59</u>		<u>1807</u>	Geol.
K.C.				Contr.
B.K.C.				Noble
Ce.				
C.				Pool
M.				Frisbie
M.				
K.				
Mz.				
Mq.				
V.				
S.				
S.				
A.				
R.				
Pe.				
G.				
T.D.	<u>4094</u>			

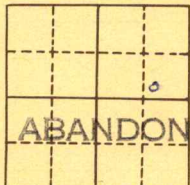

Date Comm. 11-19-55 DEC 14 1955

10" @ 596/500 DST 3901-16 open 1 1/2 hr.

rec. 1625' GIP 75' ocm 270' sw

820/30" 7" @ 4094/225 CO to 4059

16/ 3910-14 B/ 67 gw 6 hr. frac

500A S/ 11 bo 33 bw 4 hr.

16/ 4016-20 2 1/2 bo 48 bw 13 hr.

D & A