

DX 78-1


Pratt

KANSAS

Section 7 Township 26 Range 13W

Well No. #1 Donner

Company McKnab Drlg.

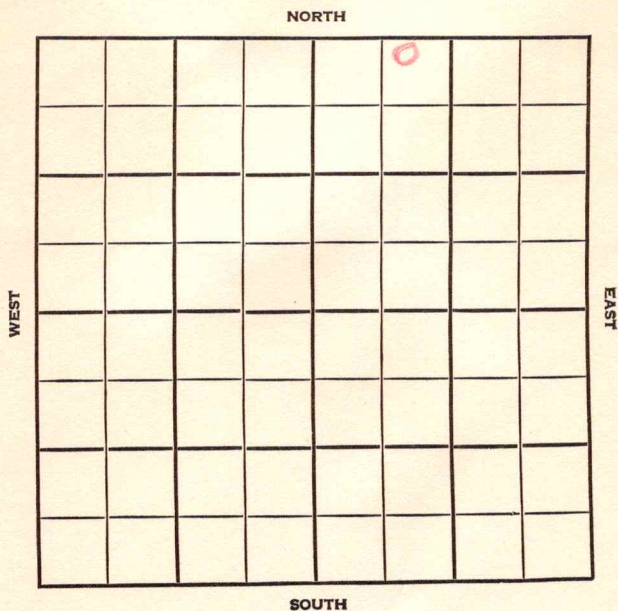

Pratt

KANSAS

SEC.	TWP.	R.
7	26	13W

WELL NO.

1 Donner

FARM

COMPANY

McKnab Drlg

CONTRACTOR

Col Tools


Frisbie

_____ Ft. from N. Line

_____ Ft. from S. Line

_____ Ft. from E. Line

_____ Ft. from W. Line

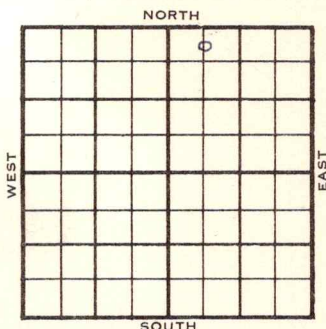C N $\frac{1}{2}$ NW NE

	ELEVATION	REPORT
1955	1958	

5/26 RUR

6/8

Comm 5-16-55

8 5/8" @ 1200

H 3611, Tr 3639, B1 3768, L 3793,

KC 4108, C 4247, M 4258, K 4273,

V 4283, S 4409, A 4468, TD 4490

DST 3942-53, open 45 min. Rec 30'

mud 125# DST 4006-40 open 1 hr

Rec 40' wtry mud 1360# DST 4256-

85 open 45 min. Rec 50' mud 225/20"

D & A

ABANDONED

Top. _____ Pool. _____

Co. _____ Facet. _____ **FIRST REPORT**

FORM 513 REV. SUNRAY

County Pratt Elev. _____
Sec. 7 Twp. 26 Rge. 13W
Company McKnab Drlg.
Farm Name Donner No. 1

Co.

Lse.

No.

S.

T.

R.

TOPS

DEPTH

DATUM

Loc. in Section

C N $\frac{1}{2}$ NW NE

Drlg. Contr.

Co. tools

Pool

Frisbie

Cim. Anhydrite
Ft. Riley
Howard
Topeka
Heebner Sh.
Toronto Ls.
Brown Lime
Lansing
Kans. City
B. K. C.
Congl.
Miss.
Kinderhook
Misener
Hunton
Sylv. Maquo
Viola
Simpson
Smp.
Gorham
Arbuckle
Basal Sand
Pre. Cam.
T. D.

Date Comm.

Date Comp.

RUR

K-26

County Pratt Elev. 1958Sec. 7 Twp. 26 Rge. 13WCompany McKnab Drlg.Farm Name Donner No. 1

TOPS	DEPTH	LOG	DATUM	Loc. in Sec.
Anh.				C N $\frac{1}{2}$ NW NE
Tr.				
H.	<u>3611</u>		<u>1653</u>	
Tr.	<u>3639</u>		<u>1681</u>	
Dg.				
BL.	<u>3768</u>		<u>1810</u>	
L.	<u>3793</u>		<u>1835</u>	
K.C.	<u>4108</u>		<u>2150</u>	Geol.
B.K.C.				Contr.
Ce.				
C.	<u>4247</u>		<u>2289</u>	Co. tools
M.	<u>4258</u>		<u>2300</u>	
M.				Pool
K.	<u>4273</u>		<u>2315</u>	
Mz.				Frisbie
Ma.				
V.	<u>4283</u>		<u>2325</u>	
S.	<u>4409</u>		<u>2451</u>	
S.				
A.	<u>4468</u>		<u>2570</u>	
R.				
Pe.				
G.				
T.D.	<u>4490</u>			

		0

Date Comm. 5-16-55 JUN 8 1955
8 5/8" @ 1200 DST 3942-53 open 45 min.Rec. 30' mud 125# DST 4006-40 open1 hr. Rec. 40' wtry mud 1360#DST 4256-85 open 45 min. Rec. 50' mud
225/20"D & A