


Section 10 Township 26 Range 13 W
 Well No. # 2 Helsel
 Company Francis Oil & Gas

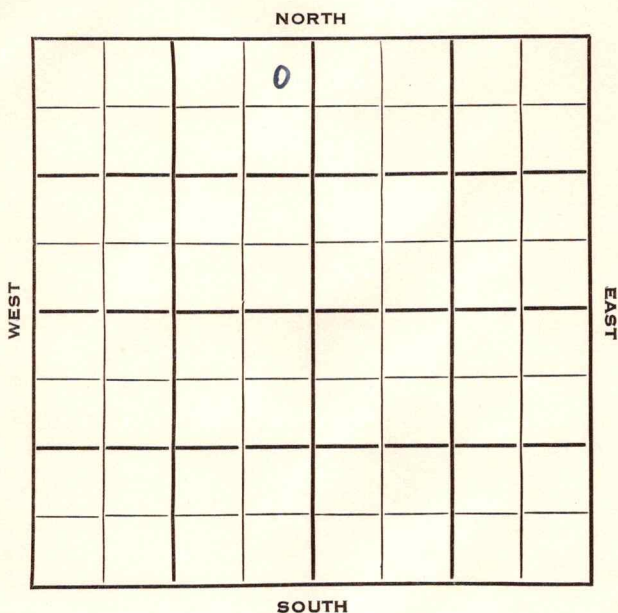

Pratt

KANSAS ✓


Sec. 10 Twp. 26 R. 13WWell No. #2 Helsel FarmFrancis Oil & Gas. CompanyArmer Contractor330 Ft. from N. Line

Ft. from S. Line

330 Ft. from E. Line

Ft. from W. Line

NE NE NW

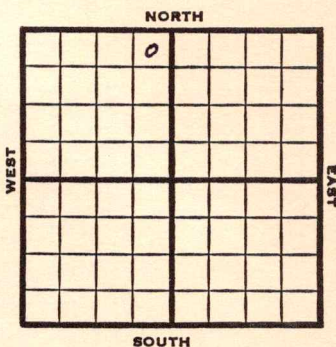1953 **Elev. 1923'** REPORT

7/1 Spud 6-28-53
8" @ 775'
WOC

7/8 **Anhy 770'**
Drilg. 3652'

7/22 N.R.

8/5 Spud 6-28-53 D & A TD 4415
8" @ 775' **Anhy 770'** **Heeb 3543**
Br lime 3625 **KC 3720**
DST 3748-76 open 1 hr rec 30' OCM
120' HOCM, 120' MCO 50' oil 10' wtr.
900#
DST 3898-3912 open 1¼ hr rec 30' SOCM
160#
DST 3937-80 open 1 hr rec 90' SOCM
Marm. 4022 **Cong 4053** **Miss 4120**
DST 4093-4170 open 1 hr gas in 4 min
rec 2,190,000 gas 1 hr, 170' GCM
90' HGCM & SSO 1580# **Kh. 4171**
Viola 4189 **Simp 4283**
DST 4289-4300 open 1 hr rec 12' mud
125#
DST 4200-4300, open 1 hr rec 20' mud
60#
DST 4290-4330 open 1 hr rec 60' mud
1265# **Arb. 4379** TD 4415 5" @ 4390

OVER

1953

8/5

(Information continued)

CO to 4415 HFW SP 4340

48/4292-4306 Perf 4128-38

SP 4185 SP 4100 500 A

1.790,000 gas. PB 3855 18/3824-30

500 A 18 BWPH PB 3775

18/3755-61 S/8 GFPH & VSSO 500 A

wtr.

D & A

ABANDONED

County Pratt State Kansas
 Sec. 10 (Blk.) 26 (Sur.) 13W Map No.
 Operator Francis Oil & Gas
 Well No. 2 Farm Helsel
 Elev. _____ Location NE NE NW

330 Ft. From N Line NW
330 Ft. From E Line Quarter
 1st. Report JUL 1 1953

Completion _____

Remarks _____

Armer - Contr.


Spudding Date 6-28-53

Drlg. Data _____

8" @ 775 WOC

J. G. McGEHEE

County Pratt State Kansas
 Sec. 10 (Blk. 26) (Sur. 13W) (Rge.) Map No. _____
 Operator Francis Oil & Gas
 Well No. 2 Farm Helsel
 Elev. 1923 Location NE NE NW

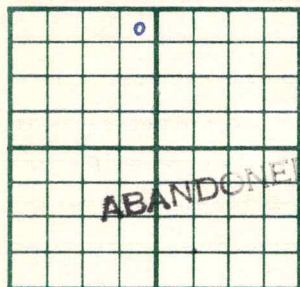

330 Ft. From N Line NW
330 Ft. From E Line Quarter
 1st. Report _____
 Completion AUG 5 1953
 Remarks _____
Armer - Contr.
 Spudding Date 6-28-53

Drlg. Data D & A TD 4415
8" @ 775 Anhy 770 Heeb. 3543
Br. lime 3625 KC 3720 DST 3748-76
open 1 hr. Rec. 30' ocm 120' hocm
120' mco 50' oil 10' wtr. 900#
DST 3898-3912 open 1 1/4 hr. Rec. 30' socm
160# DST 3937-80 open 1 hr. Rec. 90'
socm Marm. 4022 Cong. 4053 Miss. 4120
DST 4093-4170 open 1 hr. gas in 4 min.
rec. 2,190,000 gas 1 hr. 170' gcm
90' hgcm & SSO 1580# Kh. 4171
Viola 4189 Simp. 4283 DST 4289-4300
open 1 hr. Rec. 12' mud 125#
DST 4200-4300 open 1 hr. Rec. 20' mud
60# DST 4290-4330 open 1 hr. Rec. 60'm

J. G. McGEHEE

Drig. Data

1265# Arb. 4379 TD 4415 5" @ 4390

CO to 4415 HFW SP 4340 48/4298-4306

perf. 4128-38 SP 4185 SF 4100 500 A

1,790,000 gas PB 3855 18/ 3824-30

500 A 18 bwph PB 3775 18/ 3755-61

S/ 8 gfph & VSSO 500 A wtr.

D & A

AUG 1 1953

W