

Pratt

KANSAS

SECTION 6 TOWNSHIP 26 RANGE 13 W

WELL NO. #5 Fred Smith

COMPANY Texas Co.

NORTH

WEST								EAST

0

SOUTH

Pratt

KANSAS

SEC.

6

TWP.

26

R.

13W

WELL NO.

#5 Fred Smith

FARM

COMPANY

Texas Company

CONTRACTOR

Stickle

Frisbie

Ft. from N. Line

2310'


Ft. from S. Line

1650'

Ft. from E. Line

Ft. from W. Line

NE NW SE

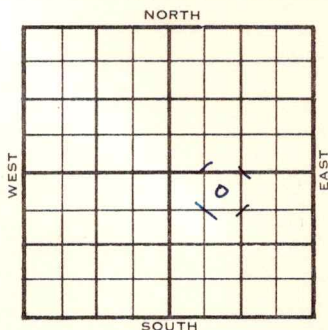

1955

ELEVATION

1953'

REPORT

10/26

Comm 10-21-55
 10" @ 599/500
 Drlg 2250

11/9

Comm 10-21-55
 10" @ 599/500

Tp

3211

H

~~3561~~

3561

Bl

~~3720~~

3720

L

3747

3745

TD

4078

DST 3943-53 open 1 hr rec 15' mud
 10' ocm 365/20" 7" @ 4077 CO to
 4041 Perf/3883-94 S/6 boph 1 hr
 2000 A F/220 bo 12 hr Comp
 440 bopd

COMPLETED

County **Pratt** Elev. _____
 Sec. **6** Twp. **26** Rge. **13W**
 Company **Texas Company**
 Farm Name **Fred Smith** No. **5**

TOPS	DEPTH	LOG	DATUM	Loc. in Sec.
Anh.				NE NW SE
Tp.				2310' SL
H.				1650' EL
Tr.				
Dg.				
Bl.				
L.				Geol.
K.C.				Contr.
B.K.C.				Stickle
Ce.				
C.				Pool
M.				Frisbie
M.				
K.				
Mz.				
Mq.				
V.				
S.				
S.				
A.				
R.				
P.				
G.				
T.D.				

FIRST REPORT

OCT 26 '55

Date Comm. **10-21-55**
10" @ 599/500 drlg. 2250

[Handwritten signature]

County Pratt Elev. 1953 Co. Co.
 Sec. 6 Twp. 26 Rge. 13W
 Company Texas Company
 Farm Name Fred Smith No. 5

TOPS	DEPTH	LOG	DATUM
Anh.			
TP.		3211	1258
H.		3561	1608
Tr.			
Dg.			
BL.		3720	1767
L.	3747	3745	1792
K.C.			
B.K.C.			
Ce.			
C.			
M.			
M.			
K.			
Mz.			
Mq.			
V.			
S.			
S.			
A.			
R.			
PE.			
G.			
T.D.	4078		

Loc. in Sec. NE NW SE

2310' SL

1650' EL

Geol. StickleContr. SticklePool Frisbie

COMPLETE

Date Comm. 10-21-55 NOV 9 1955

10" @ 599/500 DST 3943-53 open 1 hr.

rec. 15' mud 10' ocm 365/20"

7" @ 4077 CO to 4041 Perf/ 3883-94

S/ 6 boph 1 hr. 2000 A F/ 220 bo

12 hr. Comp. 440 bopd