
Pratt

KANSAS

SECTION 8 TOWNSHIP 26 RANGE 13 W

WELL NO. #1 Donner

COMPANY McKnab Drlg.

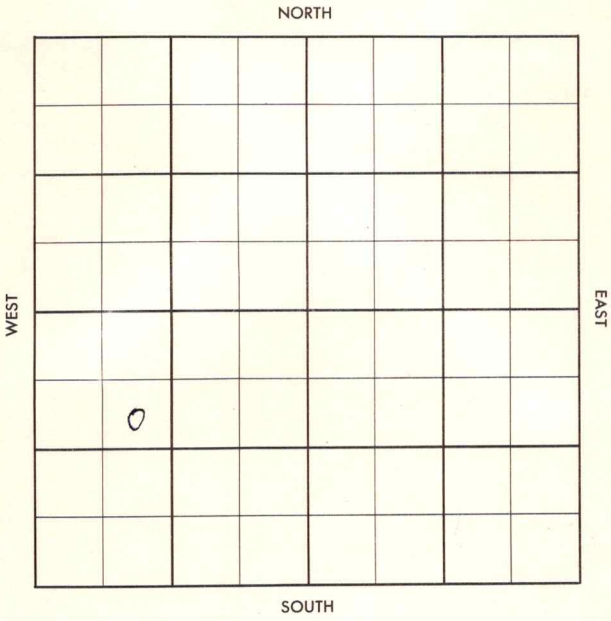

FORM 504-3 SUNRAY

Pratt KANSAS

SEC.	TWP.	R.
8	26	13W

WELL NO.

#1 Donner FARM

COMPANY

McKnab Drlg

CONTRACTOR

Co Tools

Wildcat


_____ Ft. from N. Line

_____ Ft. from S. Line

_____ Ft. from E. Line

_____ Ft. from W. Line

SE NW SW

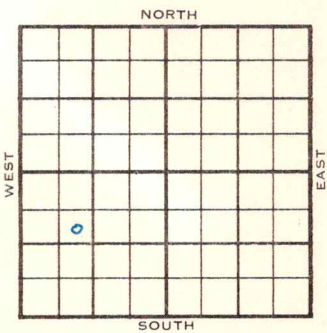

1955	ELEVATION 1954'	REPORT
10/19	Comm 10-14-55 8" @ 376/240 Drlg 2400	
11/2	Comm 10-14-55 8" @ 376/240 H 3617 B1 3768 L 3793 M ~~4226~~ 4226 V ~~4271~~ 4271 S 4369 A ~~4445~~ 4445 TD 4476 DST 4229-56 open 1 hr rec 30' mud 40/20" DST 4273-94 open 1 hr rec 30' mud 42/20" DST 4237-70 open 1 hr rec 30' mud 230/29 D & A ABANDONED	

DX-78

FORM 513 REV. SUNRAY

County Pratt Elev.

Sec. 8 Twp. 26 Rge. 13W

Company McKnab Drlg.

Farm Name Donner No. 1

TOPS	DEPTH	LOG	DATUM
Anh.			
T.P.			
H.			
Tr.			
Dg.			
B.L.			
L.			
K.C.			
B.K.C.			
Ce.			
C.			
M.			
M.			
K.			
Mz.			
Mq.			
V.			
S.			
S.			
A			
R.			
P€.			
G.			
T.D.			

Loc. in Sec. SE NW SW

Geol.

Contr. Co. tools

Pool Wildcat

FIRST REPORT

OCT 14 1955

Date Comm. 10-14-55

8" @ 376/240 drlg. 2400

Co. Lse. No. Sec. T. R.

26

FORM 513 REV. SUNRAY

County Pratt Elev. 1954

Sec. 8 Twp. 26 Rge. 13W

Company McKnab Drlg.

Farm Name Donner No. 1

TOPS	DEPTH	LOG	DATUM
Anh.			
Tp.			
H.	3617		1663
Tr.			
Dg.			
B.L.	3768		1814
L.	3793		1839
K.C.			
B.K.C.			
Ce.			
C.			
M.		4326	2272
M.			
K.			
Mz.			
Mq.			
V.		4371	2317
S.		4389	2415
S.			
A		4445	2491
R.			
P€.			
G.			
T.D.	4476		

Loc. in Sec. SE NW SW

Geol.

Contr. Co. tools

Pool Wildcat

ABANDONED

Date Comm. 10-14-55 NOV 2 1955

8" @ 376/240 DST 4229-56 open 1 hr. rec. 30' mud 40/20" DST 4273-94 open 1 hr. rec. 30' mud 42/20" DST 4237-70 open 1 hr. rec. 30' mud 230/20"

D & A

Co. Lse. No. Sec. T. R.