

Pratt


KANSAS

Section 10 Township 26 Range 13W

Well No. #1 Heizel *(Helsel)*

Company Francis Oil & Gas

NORTH

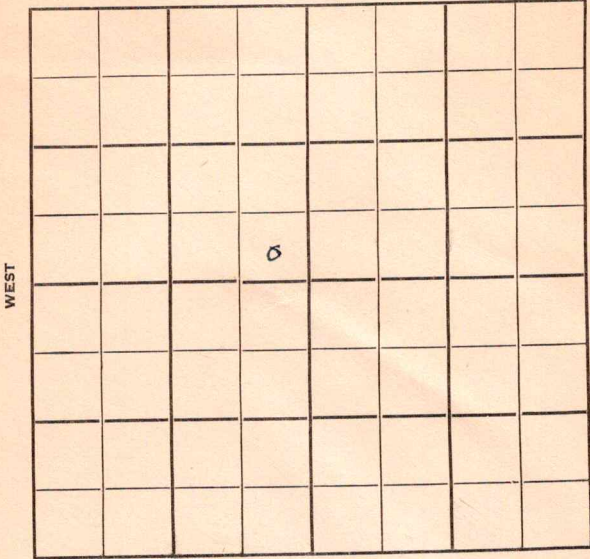

SOUTH

WEST

EAST

Sec. 10 Twp. 26 R. 13-W ✓

Well No. #1 Heizel Farm

Francis Oil & Gas Company

Veeder Supply Contractor
Wildcat


_____ Ft. from N. Line

330 Ft. from S. Line

330 Ft. from E. Line

_____ Ft. from W. Line

SE SE NW

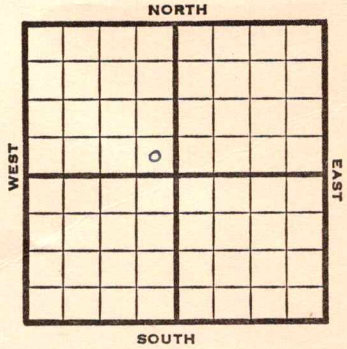

1950

Elev 1922'

REPORT

2/15

Spud 2-12-50
Drlg 512'

3/8

TD 4491'
8" @ 783'
Lans 3730'
Cong 4073'
Miss 4177'
Simp 4327'
Arb. 4441'
D&A
Aband.

ABANDONED

Map No. _____ Sec. 10 Twp. 26 R. 13W

Well No. 1 Heizel

Francis Oil & Gas Company

Veeder Supply Contractor

SE SE NW

_____ Ft. from N. Line

330 Ft. from S. Line

330 Ft. from E. Line

_____ Ft. from W. Line

Pratt County

SECTION PLAT



Location _____

Rig up _____

Drilling and Remarks:

Spud 2-12-50

drlg. 512

RECORD

Cased _____ in., _____ ft.

Sand _____

Gas _____

Oil _____

Total Depth _____

PRODUCTION

1st 24 hrs. Nat. _____

1st 24 hrs. after shot _____

Gas _____ Cu. Ft.

Dry Hole _____

Abandoned _____

Date

FEB 15 1950 19

J. E. TYRA Scout

Kansas

Wildcat

Map No. _____ Sec. 10 Twp. 26 R. 13W

Well No. 1 Heizel

Francis Oil & Gas Company

Contractor

SE SE NW

E. 1922
SECTION PLAT

_____ Ft. from N. Line

330 Ft. from S. Line

330 Ft. from E. Line

_____ Ft. from W. Line



Pratt County

Location _____

Rig up _____

Drilling and Remarks:

8' @ 783
Lans 3730
Cong 4073
Miss 4177
Simp 4327
arb 4441

RECORD

Cased _____ in., _____ ft.

Sand _____

Gas _____

Oil _____

Total Depth 4491

PRODUCTION

1st 24 hrs. Nat. _____

1st 24 hrs. after shot _____

Gas _____ Cu. Ft.

Dry Hole _____

Abandoned _____

Date

D & A

J. E. TYRA

MAR 8 1950 19

Scout