

Section 9 Township 26 Range 13 WWell No. # 1 SchrackCompany Palmer Oil

NORTH

			0				

WEST

EAST

SOUTH

Pratt

KANSAS ✓

Sec. 9 Twp. 26 R. 13W

Well No. #1 Shrack Farm

Palmer Oil

Company

Contractor


330 Ft. from N. Line

_____ Ft. from S. Line

330 Ft. from E. Line

_____ Ft. from W. Line

NE NE NW

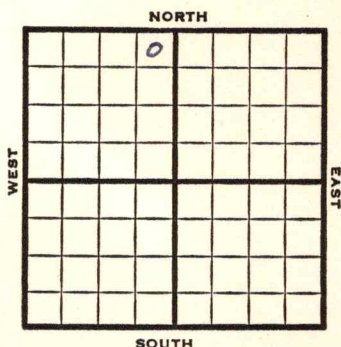

1953 **Elev. 1942'** REPORT

5/20 RUR

5/28 8" @ 389

Anhy 800

Drlg. 3619'

6/3 **Heeb 3559 Br li 3722 KC 3766**

Miss 4195

DST 4197-4217, 1 hr, 150' GCM

V 4266

Drlg. 4364

6/10 Spud 5-18-53 D & A TD 4416

8" @ 389 **Anhy 800 Heeb 3559**

Br lime 3722 KC 3766 Miss 4195

DST 4197-4217 open 1 hr rec 150' GCM

Viola 4266 Simp 4386

TD 4416 D & A

ABANDONED

County Pratt State KansasSec. 9 (Blk.) 26 (Sur.) 13W Map No.
(Twp.)Operator Palmer OilWell No. 1 Farm ShrackElev. Location NE NE NW

330 Ft. From N Line NW330 Ft. From E Line Quarter1st. Report MAY 20 1953

Completion

Remarks

Spudding Date

Drlg. Data

RUR

Operator Palmer Oil

Well No. 1 Farm Shrack

Elev.	1942	Location	NE NE NW
-------	------	----------	----------

330 Ft. From N Line NW

330 Ft. From E Line Quarter

1st. Report

Completion JUN 10 1953

Remarks

Spudding Date 5-18-53

Drig. Data D & A TD 4416

8" @ 389 Anhy 800 Heeb. 3559

Br. lime 3722 KC 3766 Miss. 4195

DST 4197-4217 open 1 hr. Rec.

150' gcm Viola 4266 Simp. 4386

TD 4416

D & A

J. G. McGEHEE