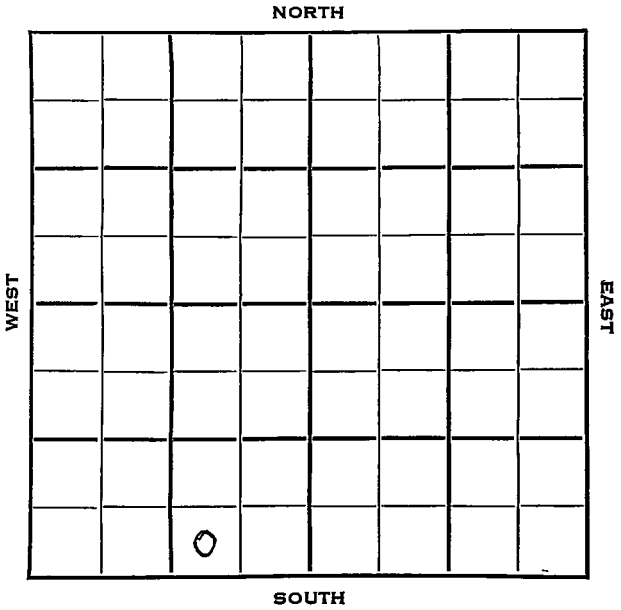


Section 23 Township 26 Range 13^WWell No. #1 GobinCompany H.L. Moore

SEC. 1 TWP. R. 23 26 13 W ✓

WELL NO.

1 Gobin

FARM

COMPANY

H. L. Moore

CONTRACTOR

Reserve Drlg.

Wildcat

Ft. from N. Line

330


Ft. from S. Line

990

Ft. from E. Line

Ft. from W. Line

SW SE SW

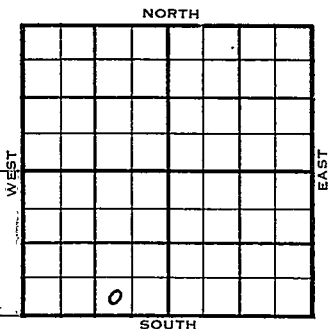

MCPC has SE $\frac{1}{4}$ of 22 Amerada F/O

	ELEVATION	REPORT
1954	1945'	
1/20	Spud 1-14-54 8" @ 821 Drlg. 2300'	
1/29	Heebner 3573' Brown lime 3739' Lansing 3759' DST 4029-49', open 1 hr, rec 8' mud. BHP 0# Base K. C. 4202' Viola 4214' DST 4209-59', open 1 hr, rec 570' XXXX heavily O & GCM & MCO. BHP 975# Simpson 4257' DST 4262-78', open 1 hr., rec 300' oil & 300' salty oil. BHP 1020# Drlg. ahead. (Tel-McGehee)	
2/2	Top Viola 4214' Top Simpson 4257' Top Arbuckle 4350' Took DST 4280-4296' open 1 hr, gas to surface in 31 mins, rec 300' gassy oil. BHP 930# DST 4352-78', open 1 hr, gas to surface in 55 mins, recovered 2600' clean oil. BHP 1335# TD 4378' Will run pipe & set about 4352' in Arb. Looks like it may produce in Viola, Simpson & Arbuckle. (Tel-McGehee)	

OVER

~~Twp. _____ Pool _____~~
~~O.W.P.B.~~
~~Class _____ Fleet _____~~

S-513-B

County Pratt Elev. 1945
 Sec. 23 Twp. 26 Rge. 13W
 Company Gulf Oil
 Farm Name Gobin No. 1

TOPS	DEPTH	LOG	DATUM
Anh.			
Tp.			
H.			
Tr.			
Dg.			
B.L.			
L.			
K.C.			
B.K.C.			
Ce.			
C.			
M.			
M.			
K.			
Mz.			
Mq.			
V.	<u>h214</u>		
S. <u>do l.</u>	<u>h271</u>		
S. <u>sd</u>	<u>h280</u>		
A.	<u>h350</u>		
R.			
Pf.			
G.			
T.D.			

Loc. in Sec. SW SE SW
OWPB
 Genl. O.W.P.B.
 Contr. _____
 Pool _____

COMPLETE
 JUN 18 1950
 FIRST REPORT
 COMPLETE

Date Comm. 5" @ 4354 PB 4268 44/ 4236-47
8/ 4230-32 24/ 4222-28 FU 150' oil
12 hr. viso-frac P/ 121 bo 24 hr.
P & F/ 129 bo 20 hr.
Comp. P & F/ 129 bopd

Co. _____
 Lse. _____
 No. _____
 Sec. _____
 T. _____
 R. _____

County Pratt State Kansas

Sec. 23 (Blk.) 26 (Sur.) 13W Map No.

Operator H. J. Moore

Well No. 7 Farm Gobin

Elev.	1945	Location	SW SE SW
-------	------	----------	----------

0

330 Ft. From S Line SW

990 Ft. From E Line Quarter

1st. Report JAN 20 1954

Completion Amerasia Farmout

Remarks MCPC has SE $\frac{1}{2}$ of 22


Reserve Drlg. - Contr.

Spudding Date 1-14-54

Drig. Data Wildcat

8" @ 821 drlg. 2300

County Pratt State Kansas
 Sec. 23 (Blk.) 26 (Sur.) 13W Map No.
 Operator H. L. Moore
 Well No. 1 Farm Gobin
 Elev. 1945 Location SW SE SW

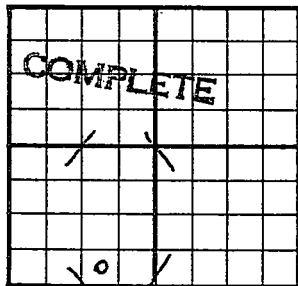

330 Ft. From S Line SW
990 Ft. From E Line Quarter

1st. Report

Completion MAR 3 1954

Remarks Wildcat

Reserve Drlg. & Contr.

Spudding Date 1-14-54

Drlg. Data Oil well TD 4378

8" @ 821 Heeb. 3573 Br. lime 3739

Lans. 3759 DST 4029-49 open 1 hr.

Rec. 8' mud 0# Kh. 4202 Viola 4214

DST 4209-59 open 1 hr. Rec. 570' ho &
gcm & mco 975# Simp. 4257

DST 4262-78 open 1 hr. Rec. 300' oil
300' frothy oil 1020# Simp. sd. 4280

DST 4280-96 open 1 hr. gas in 31 min.
Rec. 300' gassy oil 930# Arb. 4350

DST 4352-78 open 1 hr. gas in 55 min..

Rec. 2600' clean oil 1335# TD 4378

5" @ 4354 CO to 4378 S/ 30 boph

Comp. 410 bopd

J. G. McGEHEE