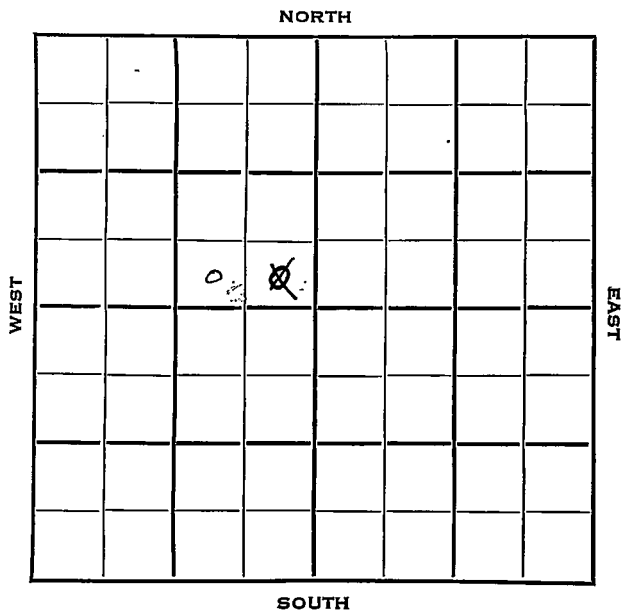


Section 21 Township 26 Range 13WWell No. 1 DodsonCompany A. G. Hill (Dallas, Texas)

SEC.	TWP.	R.
21	26	13W ✓

WELL NO.

1 Dodson

FARM

COMPANY

A. G. Hill (Dallas, Texas)

CONTRACTOR

Reserve Drlg.


Wildcat

_____ Ft. from N. Line

330 _____ Ft. from S. Line

~~990~~
~~330~~ _____ Ft. from E. Line

_____ Ft. from W. Line

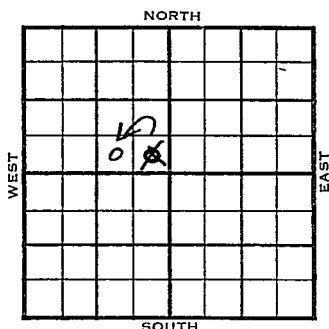SW
SE SE NW

	ELEVATION	REPORT
1954	1938'	
2/10	Spud 2-5-54 8" @ 240' Drlg. 1481'	
2/17	Heeb 3605', Br. L. 3777', Lans 3809' DST 3832'-50' 1 hr, 150' gc & socm 180' SW 1380# DST 3958'-68' 1/2 hr, failed. 240' M Drlg 4000'	
2/25	B KC 4120' Cong. 4247' Miss. 4281' Kh. 4304' Viola 4327' Simp. 4414' DST 4414-28 open 1 1/2 hr rec 80' HO & GCM, 120' MCO, 175' clean oil, 1410# DST 4428-56, open 1 1/2 hr rec 65' MCO, 150' SMC0, 1465# Drlg. 4519' (Ltr-McGehee)	
3/4	Arb. 4508' TD 4560' Schl 5" @ 4500 96/4421-37 S/74 BO 24 hr. Gr. 39 250 mud-acid. 250 A S/3 1/2 BOPH sd-oil-frac. (Ltr-McGehee)	
3/11	P/8 BOPH " "	
3/17	N.R.	

OVER

1954

3/24

Spud 2-5-54

Oil Well

TD 4560'

8" @ 240'

Heeb 3605', Br. Lime 3777', Lans
3809',

DST 3832'-50' opn 1 hr, rec 150' gc &
soem, 180' sw 1380#

DST 3958'-68' opn $\frac{1}{2}$ hr, failed. rec
240' Mud B KC 4120', Cong 4247'

Miss 4281', Kh 4304', Viola 4327'

Simp 4414'

DST 4414'-28' opn $1\frac{1}{2}$ hr, rec 80' ho &
gcm 120' mco 175' clean oil 1410#

DST 4428'-56' opn $1\frac{1}{2}$ hr, rec 65' mco, 1
150' smco 1465#

Arb 4508'

TD 4560'

5" @ 4500'

CO to TD

96/ 4421-37 S/ 74 bo 24 hr.

250 mud-acid

250 A

S/ $3\frac{1}{2}$ boph sd-oil-frac P/ 8 boph

Comp 168 bopd 10% Wtr.

COMPLETED

County Pratt State Kansas

Sec. 21 (Blk. Twp.) 26 (Sur. Rge.) 13W Map No.

Operator A. G. Hill

Well No. 1 Farm Dodson

Elev. 1938 Location SW SE NW

0

COMPLETE

330 Ft. From S Line NW

990 Ft. From E Line Quarter

1st. Report

Completion MAR 24 1954

Remarks Wildcat

Reserve Drlg. - Contr.

Spudding Date 2-5-54

Drilg. Data Oil well TD 4560

8" @ 240 Heeb. 3605 Br. lime 3777

Lans. 3809 DST 3832-50 open 1 hr.

Rec. 150' gc & socm 180' sw 1380#

DST 3958-68 open $\frac{1}{2}$ hr. failed Rec.

240' mud B KC 4120 Cong. 4247

Miss. 4281 Kh. 4304 Viola 4327

Simp. 4414 DST 4414-28 open $1\frac{1}{2}$ hr.

Rec. 80' ho & gcm 120' mco 175' clean

oil 1410# DST 4428-56 open $1\frac{1}{2}$ hr.

Rec. 65' smco 150' smco 1465#

Arb. 4508 TD 4560 5" @ 4500 CO to TD

96/ 4421-37 S/ 74 bo 24 hr. 250 mud-acid

250 A S/ $3\frac{1}{2}$ boph sd-oil-frac P/ 8 boph

Comp. 168 bopd 10% wtr.

J. G. McGEHEE

County Pratt State Kansas
 Sec. 21 (Blk. 26 (Sur. 13W Map No.
 (Twp.) (Rge.)
 Operator A. G. Hill (Dallas, Texas)
 Well No. 1 Farm Dodson
 Elev. Location SE SE NW

330 Ft. From S Line NW

330 Ft. From E Line Quarter

1st. Report FEB 10 1954

Completion

Remarks

Reserve Drlg. - Contr.

Spudding Date 2-5-54

Drlg. Data Wildcat

8" @ 240 drlg. 1481

Kansas

Map No. _____ Sec. 21 Twp. 26 R. 13WWell No. 1 Dodson

_____ A. G. Hill _____ Company

CORRECTION _____ Contractor

SW SE NW

SECTION PLAT

_____ Ft. from N. Line

330 Ft. from S. Line990 Ft. from E. Line

_____ Ft. from W. Line

	o		

Pratt County

Location _____

Rig up _____

Drilling and Remarks:

Reported
SE SE NW

RECORD

Cased _____ in., _____ ft.

Sand _____

Gas _____

Oil _____

Total Depth _____

PRODUCTION

1st 24 hrs. Nat. _____

1st 24 hrs. after shot _____

Gas _____ Cu. Ft.

Dry Hole _____

Abandoned _____

Date

FEB 24 1954

J. G. McGEHEE

Scout