

Pratt KANSAS

DX 78-1


O. W. P. B

Section 23 Township 26 Range 13W

Well No. 2 Gobin

Company H. L. Moore

NORTH

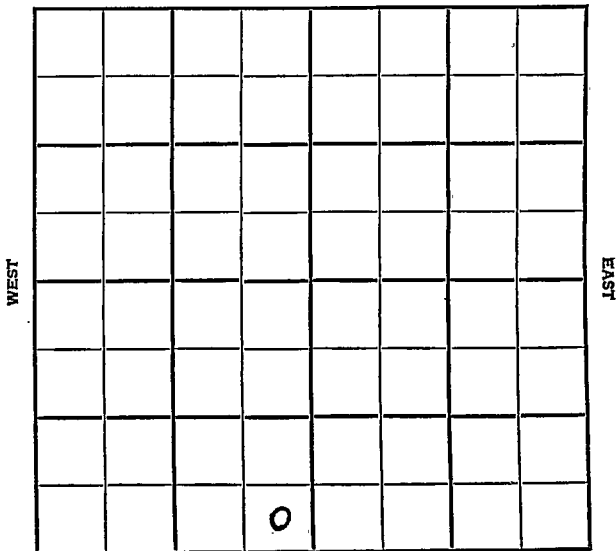

SOUTH

SEC.	O. W. TWP.	R.
23	26	13W

WELL NO.

2 Robin

FARM

COMPANY

H. L. Moore

CONTRACTOR

Reserve Drlg.

NW Iuka-Carmi Pool

\_\_\_\_\_ Ft. from N. Line


330 \_\_\_\_\_ Ft. from S. Line

330 \_\_\_\_\_ Ft. from E. Line

\_\_\_\_\_ Ft. from W. Line

SE SE SW

MCPC has SE/4 of Sec. 22

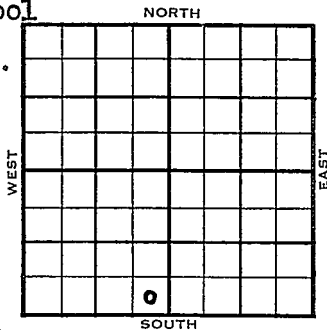

	ELEVATION	REPORT
1954	1946'	
8/4		Spud 7-29-54 8" @ 554' Anhy 800' Drlg. 2450'
9/22		Spud 7-29-54 Oil Well TD 4378' 8" @ 554' Anhy 800', Heeb 3570', Br. Lime 3741' Lans 3761', Miss 4187', Kh. 4208' Viola 4218' DST 4213'-55' opn 1 hr, rec 150' so & gcm, 640# Simp 4260' DST 4260'-80' opn 1 hr, rec gas in 20 min, rec 15' ho & gcm 60' mo 360' smo 1015# DST 4279'-85' opn 1/2 hr, rec 85' drlg. mud. DST 4355'-61' opn 1 hr, rec 180' Muddy oil, 180' green oil 120' ho & gcm 180' so & gcm 120# TD 4378' Arb 4359' 50 @ 4361' CO to 4378 300 A P/ 116 bo Comp 124 bopd.

1955

O. W. P. B.

3/16

OTD 4378'

Heeb 3570' Br. Lime 3741' KC 3761'

Miss 4187' Kh. 4208' Viola 4218'

Simp sh. 4260', Arb. 4359

5" @ 4361'

PB 4314

88/ 4268-79 100 M-A

FU 400' oil 12 hr. 250 A frac.

Comp 143 bopd.

FIRST REPORT

*f*

COMPLETED







Twp. ~~Pratt~~ Pool. ~~Pratt~~

~~O.W.P.B.~~ ~~Pratt~~

S-513-B

County Pratt Elev. 1946  
 Sec. 23 Twp. 26 Rge. 13W  
 Company Gulf Oil  
 Farm Name Gobin No. 2

TOPS	DEPTH	LOG	DATUM
Anh.			
Tp.			
H.			
Tr.			
Dg.			
B.L.			
L.			
K.C.			
B.K.C.			
Ce.			
C.			
M.			
M.			
K.			
Mz.			
Mq.			
V.	1218		
S.	1260		
S.			
A.	1359		
R.			
Pf.			
G.			
T.D.			

Loc. in Sec. SE SE SW  
O.W.P.B.  
 Geo. O.W.P.B.  
 Contr. \_\_\_\_\_  
 Pool \_\_\_\_\_

**COMPLETE**  
 JUN 18 1989  
**FIRST REPORT**

Date Comm. \_\_\_\_\_  
5" @ 1361 PB 4259 48/ 4224-36  
1/ 4227 1/ 4233 vibra-frac PB 4248  
48/ 4224-36 viso-frac P/ 52 bo 24 hr  
P/ 80 bo 48 hr. Comp.

Co. \_\_\_\_\_  
 No. \_\_\_\_\_  
 Sec. \_\_\_\_\_  
 T. \_\_\_\_\_  
 R. \_\_\_\_\_