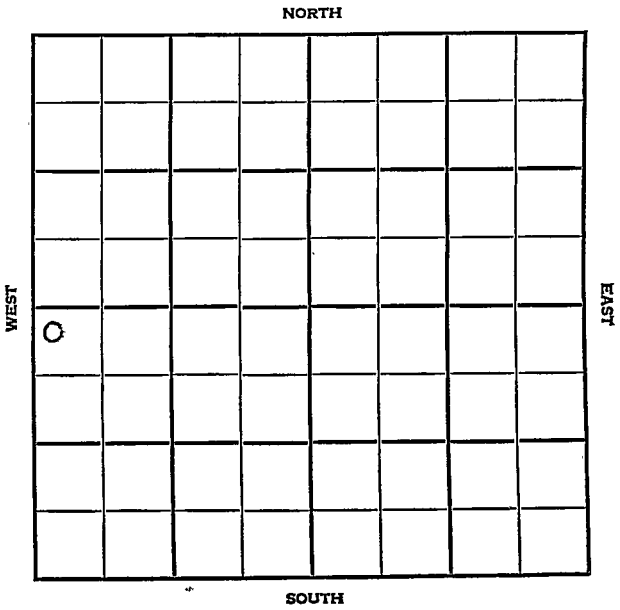


Section 23 Township 26 Range 13WWell No. 2 Gobin "A"Company W. H. Amis, Jr.

KANSAS

WELL NO.

FARM

COMPANY

W. H. Amis, Jr.

CONTRACTOR

Peel Bros.

Luka-Carmi


Ft. from N. Line

Ft. from S. Line

Ft. from E. Line

Ft. from W. Line _____

NW NW SW

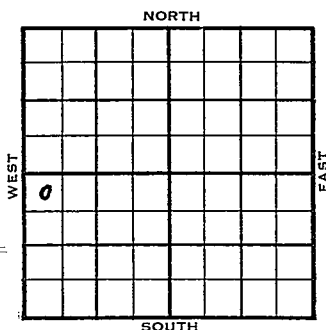

SDX - Offset

1955	ELEVATION	REPORT
	1931	

7/20 Comm. 7-17-55
8" @ 803' WOC - TITE HOLE

7/27	No report
------	-----------

8/4	Trite hole, no report
-----	-----------------------

8/10 | Comm 7-17-55

H 3592

BL 3763

L 3784

BKC 4114

M 4270

K 4291

V 4306

S 4389

A 4481

TD 4492

8" 803 DST 4298-4320 1 hr rec 10'

Ma BHP 25 DST 4384-4450 1 hr rec 30'

Ma BHP 1445 D & A

ABANDONED

County Pratt Elev. _____
 Sec. 23 Twp. 26S Rge. 13W
 Company W. H. Amis, Jr.
 Farm Name Gobin "A" No. 2

TOPS	DEPTH	LOG	DATUM	Loc. in Sec.
Anh.				NW NW SW
Ip.				
H.				
Tr.				
Dg.				
Bl.				
L.				Geol. J. McGathan
K.C.				Contr.
B.K.C.				Peel Bros.
Ce.				Pool
C.				
M.				
M.				
K.				
Mz.				Tulca-Garmi
Mo.				
V.				
S.				
S.				
A.				
R.				
Pe.				
G.				
T.D.				

FIRST REPORT

JUL 20 '55

Date. Comm. 7/17/558" 803 WOC

Note: tite hole

26

County Pratt Elev. 1931
 Sec. 23 Twp. 26S Rge. 13W
 Company W. H. Amis, Jr.
 FarmName Gobin "A" No. 2

TOPS	DEPTH	LOG	DATUM	Loc. in Sec.
Anh.				NW NW SW
Tr.				
Dg.				
BL.	3592		1661	
L.				
K.C.	3763		1832	
B.K.C.	3784		1853	Geol. J. McGathan
Ce.				Contr.
C.				Peel Bros.
M.	4270		2339	Pool
M.				
K.	4291		2360	Iuka-Carmi
Mz.				
Me.				
V.	4306		2375	
S.	4389		2458	
S.				
A.	4481		2550	
R.				
Pe.				
G.				
T.D.	4492			

AUG 10 1955

ABANDONED

Date Comm. 7/17/55 8th 803DST 4298-4320 1 hr rec. 10' Md BHP 25DST 4384-4450 1 hr rec. 30' Md BHP 1445

D & A