


Section 25 Township 26 Range 13-W
Well No. #1 Knop "B"
Company Skelly

Wildcat

NORTH

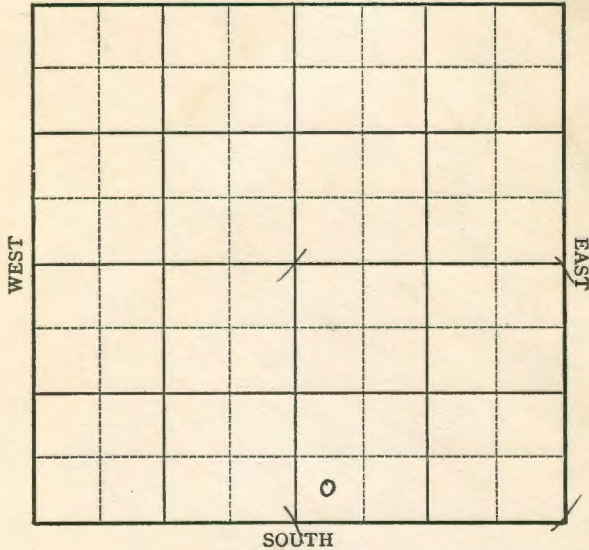

Sec. 25 Twp. 26 R. 13-W
Well No. #1 Knop "B" Farm
Skelly Company

Wildcat


Ft. from N. Line

330 Ft. from S. Line

Ft. from E. Line

330 Ft. from W. Line

SW SE

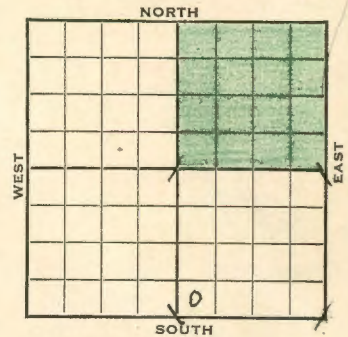

1942 Elev. 1928 REPORT

12/2	Loc.
12/9	8" @ 401 WOC
12/16	Drlg. 2600'
12/30	Viola 4140 Simpson shale 4219 Simpson sand 4231-68 showed some porosity - no show of oil Top Arb. 4335-41 slight stain and porosity Running 4" casing. (Tel)
12/22	Lans. 3732 Slight Porosity & saturated 3753-57, 3761-67, 3880-86. Drlg. 3900'
12/30	Viola 4140 Drlg. 4221 Simpson shale 4219 Simpson sand 4231-68 Showed some porosity - no show of oil Top Arb. 4335-41 Slight stain and porosity Running 4" casing. (Tel)
1943 1/6	Arb. 4335 4334 T.D. 4341 SSO 4" - 4339 RUST

OVER

1943

1/13 Arbuckle 4334 200' oil 1 hr.
T.D. 4341 500' oil 2 hr.
Sixteen hundred feet oil - 6 hours
Gravity 40.9 (Telegram)

1/14 Total Depth 4341½
Filled 3300 feet oil - 12 hours (Telegram)

1/14 Hole fill up 4290 feet with oil
Swab 80 bbls oil in 7 hrs
800 feet off bottom (Tel)

1/20 500 gals. acid
Swab 10 to 12 bbls. oil per hr.
1000 gals. acid.

1/28 Shut down for tanks.

2/3 " " "

2/10 Depthograph Potential 1629 - no water
(Telegram)

2/10 Arb 4334
4" @ 4338'
T.D. 4341½'
1500 gal acid
Depth pot 1629
Gravity 40.9

4334
1923
2406

COMPLETED

O.W.P.B.

1954

10/27 Oil Well
TD 4341'
Miss 4134', Viola 4162', Simp sh. 4213'
Simp. dol. 4231', Simp sd 4250',
Arb. 4326',
5" @ 4327'
OTD 4341'
PB 4300'
50/ 4291-96 250 A
PB 4280'
30/ 4263-68 250 A sd-oil-frac. S/ 27
bwpd PB 4259'
42/ 4251-58 250 A sd-oil-frac S/ 14 bw

1954

#1 Knop "B"
Information brought forward.

10/27

16 hr.
PB 4242'
54/ 4232-41 sd-oil-frac
Comp 12 bopd. 12 bw.

FIRST REPORT
COMPLETED

Pratt

Map No. 83 Sec. 25 Twp. 26 R. 13WWell No. 1 Knop "B"

Skelly

Company

COMPLETED

Contractor


SW SE

SECTION PLAT

Ft. from N. Line

330 Ft. from S. Line

Ft. from E. Line

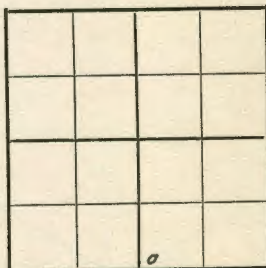330 Ft. from W. Line

WILDCAT

Location

Rig up

Drilling and Remarks:

Core 43344" @ 43381500 GradLog # 112840? hr

RECORD

Cased in. ft.

Sand

Gas

Oil

Total Depth 4341 1/2

PRODUCTION

1st 24 hrs. Nat.

1st 24 hrs. after shot

Gas Cu. Ft.

Dry Hole

Abandoned

Date

FEB 10 1943 19

S. J. LEWIS

Scout

KANSAS

Pratt

Map No. 83 Sec. 25 Twp. 26 R. 13WWell No. 1 Knox "B"

Skelly

Company

FIRST REPORT

Contractor


SW SE

SECTION PLAT

Ft. from N. Line

330 Ft. from S. Line

Ft. from E. Line

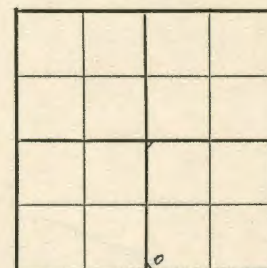330 Ft. from W. Line

WILDCAT

Location XX

Rig up

Drilling and Remarks:

RECORD

Cased in. ft.

Sand

Gas

Oil

Total Depth

PRODUCTION

1st 24 hrs. Nat.

1st 24 hrs. after shot

Gas Cu. Ft.

Dry Hole

Abandoned

Date

DEC 2 1942 19

S. J. LEWIS

Scout