



Section 25 Township 26 Range 13-W
Well No. #2 Knop "B"
Company Skelly

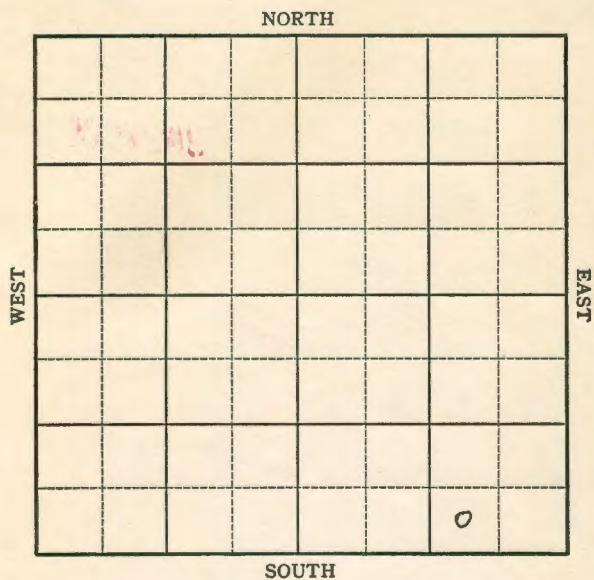

Sec. 25 Twp. 26 R. 13-W
Well No. #2 Knop "B" Farm
Skelly Company

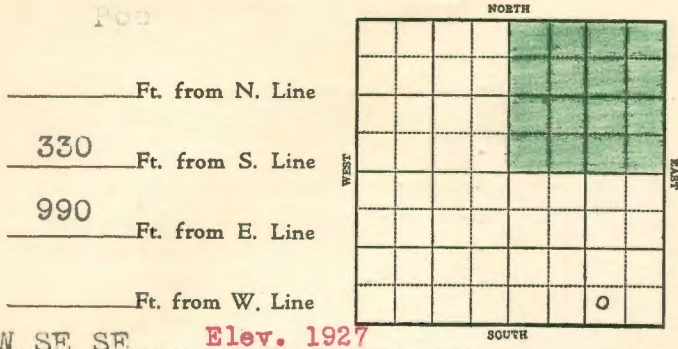

SW SE SE Elev. 1927

1943 REPORT

2/17 Rotary.
2/24 8" @ 346'
Drlg. 2200'
3/3 Drlg. 3915'
3/10 Lans 3721
Viola 4107
Simp. shale 4195
Simp. Dlol. 4205
Simp. sd. 4228
Stains and Poros. Arb. 4313-17 T.D.
Stains.
5" @ 4313½' RUST
3/17 Arb. 4313
Bottom rotary hole 4317
5" - 4313½'
Drilled plugs - no show
Drilled deeper to 4324
Filled up with 300' oil 1st hour
Drilled deeper to 4329 T.D.
1100' oil 4 hours
Acidize 750 gals
Swabbed 187 bbls oil 6 hours
2200' off bottom
Reacidized 2000 gals
Flowed 45 bbls per hour for 3 hours
Still testing (Tel)

Running 20' higher on Arbuckle than Skelly
#1 Knox "B" in the SW SE of 25-26-13W.
Depth. Potential 1629 bbls. (Hatcher)

OVER

O. W. P. B.

1943

3/19 Bomb potential 6195 bbls (Telegram)

3/24

Arb. 4313

5" @ 4313 $\frac{1}{2}$ '

T.D. 4329'

2750 gal. acid

Bomb. Pot. 6195

Max. 3000

Gravity 40.9

COMPLETED

4313

1927

2386

O. W. P. B.

1954

3/3

Oil well TD 4327 Lans 3703'

Miss 4107' Simp. sh. 4195'

Simp. dol. 4216 Simp. sd. 4228'

Arb. 4311' OTD 4327 PB 4245

30/4234-39 18/4229-32 sd-oil-frac.

S/1 BO 13 BW 3 hr. PB 4223

34/4216-22 S/20 BO 20 BW 12 hr.

sd-oil-frac. S/4 BO 29 BW 24 hrs.

CO 4277 30/4261-66 sd-oil-frac.

Comp. 16 BOPD 3 BW

FIRST REPORT

COMPLETED

County	Pratt	State	Kansas
Sec.	25 (Blk. Twp.)	26 (Sur. Rge.)	13W Map No.
Operator	Skelly Oil		
Well No.	2	Farm	Knop "B"
Elev.	1927	Location	SW SE SE
FIRST REPORT  COMPLETE		330 Ft. From	S Line SE
		990 Ft. From	E Line Quarter
		Ist. Report	MAR 3 1954
		Completion	MAR 3 1954
Remarks	O.W.P.B.		
Spudding Date			

Drig. Data Oil well TD 4327

Lans. 3703 Miss. 4107 Simp. sh. 4195

Simp. dol. 4216 Simp. sd. 4228

Arb. 4311 OTD 4327 PB 4245 30/4234-39

18/4229-32 sd-oil-frac S/1 bo 13 bw

3 hr. PB 4223 34/4216-22 S/20 bo

20 bw 12 hr. sd-oil-frac S/4 bo 29 bw

24 hr. CO 4277 30/4261-66 sd-oil-frac

Comp. 16 bopd 3 bw

J. G. McGEHEE

Pratt

Map No. 83 Sec. 25 Twp. 26 R. 13WWell No. 1 Knop "B"

Skelly

Company

COMPLETED

Contractor

SW SE

SECTION PLAT

Ft. from N. Line

330 Ft. from S. Line

Ft. from E. Line

330 Ft. from W. Line

WILDCAT

Location

Rig up

Drilling and Remarks:


RECORD

Cased in. ft.

Sand

Gas

Oil

Total Depth 4341 1/2

PRODUCTION

1st 24 hrs. Nat.

1st 24 hrs. after shot

Gas Cu. Ft.

Dry Hole

Abandoned

Date

FEB 10 1943

19

S. J. LEWIS

Scout

Pratt

KANSAS

Map No. 83 Sec. 25 Twp. 26 R. 13WWell No. 2 Knop "B"

Skelly

Company

FIRST REPORT

Contractor

SW SE SE

SECTION PLAT

Ft. from N. Line

330 Ft. from S. Line990 Ft. from E. Line

Ft. from W. Line

Pool not named

Location

Rig up

Drilling and Remarks:

Rotary

RECORD

Cased in. ft.

Sand

Gas

Oil

Total Depth

PRODUCTION

1st 24 hrs. Nat.

1st 24 hrs. after shot

Gas Cu. Ft.

Dry Hole

Abandoned

Date

FEB 17 1943

19

S. J. LEWIS

Scout

KANSAS

Map No. 83 Sec. 25 Twp. 26 R. 13WWell No. 2 Knop "B"

Skelly

Company

COMPLETED

Contractor

SW SE SE

SECTION PLAT

Ft. from N. Line

330 Ft. from S. Line990 Ft. from E. Line

Ft. from W. Line

Pool Not Named

Location

Rig up

Drilling and Remarks:


RECORD

Cased _____ in. _____ ft.

Sand _____

Gas _____

Oil _____

Total Depth 4329

PRODUCTION

1st 24 hrs. Nat. _____

1st 24 hrs. after shot _____

Gas _____ Cu. Ft.

Dry Hole _____

Abandoned _____

Date

MAR 24 1943 19

S. J. LEWIS Scout