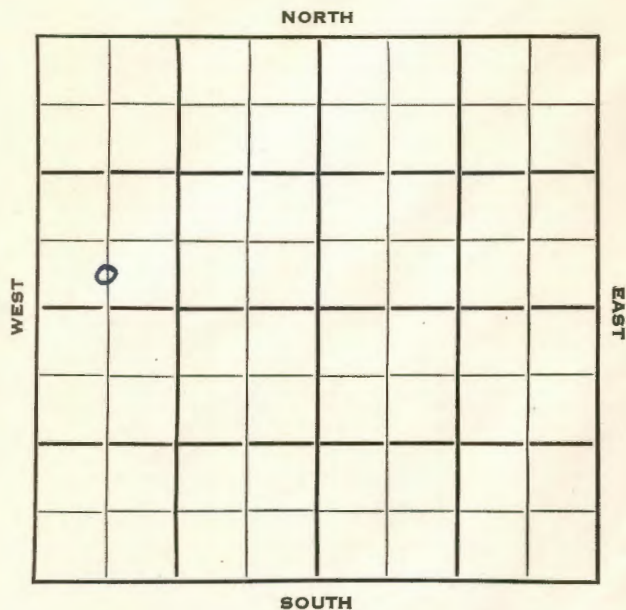


Pratt KANSAS

Section 25 Township 26 Range 13WWell No. 2 LuntCompany Beardmore Drlg.

SEC. 25 TWP. 26 R. 13 W **Pratt KANSAS**

WELL NO. # 2 Lunt FARM

COMPANY Beardmore Drlg.

CONTRACTOR Beardmore

Iuka-Carmi Pool


Ft. from N. Line

330 Ft. from S. Line

Ft. from E. Line

660 Ft. from W. Line

C S L SW NW

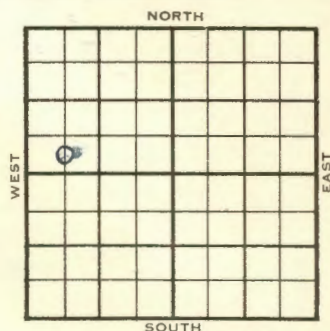

1954

ELEVATION
1936'

REPORT

5/5

Spud 4-29-54
8" @ 376 Drlg. 2850'
Anky 760'

5/12

Heeb 3542', Doug 3609', Br. L. 3705'
Lans 3732', Miss 4137', Kh. 4160'
V 4175'
DST 4176'-4210' 1 hr, 60' M 150#
Simp sho 4233', Sim sd 4263'
DST 4246'-72' 1 hr, 90' gcm, 60' o &
gcm, 120' oily gcw, 800#
RTD 4301'
5" @ 4301'

5/19

WOCT.

6/30

Spud 4-29-54 - Oil Well
TD 4301'
8" @ 376'
Anky 760', Heeb 3542', Doug 3609',
Br line 3705', Lans 3732', Miss 4137',
Kh 4160', Viola 4175'
DST 4176'-4210', opn 1 hr., rec. 60'
mud, 150#
Simp. sh 4233, Simp. sd 4263'
DST 4246-72, opn 1 hr., rec. 90' gcm,
60' o & gcm, 120' oily gcw, 800#

DX-78

OVER

(Information Brought Forward)

1954
6/30

TD 4301'
5" @ 4301'
CO to 4281'
18/4263-66, 2 bwph
PB 4258', 30/4251-56, 20 go 6 gwph
24/4247-51, 30 go 14 gwph
250 M-A
Sd-frac
S/9 bo 6 bwph
S/67 bo 17 bw 14 hrs.
S/9 bo 6 bwph
P/50 bo 50 bwph
Comp. 67 bopd 61% wtr.

COMPLETED

County	Pratt		State	Kansas	
Sec.	25	(Bk. Twp.)	26	(Sur. Rge.)	13W Map No.
Operator	Beardmore Drlg.				
Well No.	2	Farm	Lunt		
Elev.	1936	Location	C S L SW NW		
		330 Ft. From S Line		NW	
		660 Ft. From W Line		Quarter	
		1st. Report			
		Completion JUN 30 1954			
		Remarks Iuka-Carmi Pool			
		Beardmore - Contr.			
		Spudding Date 4-29-54			
		Drlg. Data Oil well TD 4301			
8" @ 376 Anhy 760 Heeb. 3542					
Doug. 3609 Br. lime 3705 Lans. 3732					
Miss. 4137 Kh. 4160 Viola 4175					
DST 4176-4210 open 1 hr. Rec. 60' mud					
150# Simp. sh. 4233 Simp. sd. 4263					
DST 4246-72 open 1 hr. Rec. 90' gcm					
60' o & gcm 120' oily gow 800#					
TD 4301 5" @ 4301 CO to 4281					
18/ 4263-66 2 bwph PB 4258					
30/ 4251-56 20 go 6 gwph 24/ 4247-51					
30 go 14 gwph 250 M-A sd-frac					
S/ 9 bo 6 bwph S/ 67 bo 17 bw 14 hr.					
S/ 9 bo 6 bwph P/ 50 bo 50 bwpd					
Comp. 67 hopt 61% w tr.					

J. G. McGEHEE

County Pratt State Kansas
 Sec. 25 (Blk. 26 (Sur. 13W Map No. Map No.)
 Operator Beardmore Drlg.
 Well No. 2 Farm Lunt
 Elev. _____ Location C S L SW NW
 _____ 350 Ft. From S Line NW
 _____ 660 Ft. From N Line _____ Quarter
 Ist. Report MAY 5 1954
 Completion _____
 Remarks _____
 _____ Beardmore - Contr.
 _____ Spudding Date 4-29-54
 _____ Drig. Data Luka-Garmi Pool
 _____ 8" @ 376 drlg. 2850 Anhy 780

J. G. McGEHEE